

MISSISSIPPI DEPARTMENT OF ENVIRONMENTAL QUALITY
Office of Land and Water Resources

P. O. Box 10631
Jackson, MS 39289-0631
WATER WELL DRILLERS LOG

COUNTY WELL LOCATED <u>Jackson</u>	
WELL NUMBER <u>F-191</u>	CODED
DATE WELL COMPLETED <u>2-10-04</u>	

PERMIT NUMBER
NAME OF DRILLING FIRM <u>Coast Water Well Service</u>

NAME & MAILING ADDRESS OF LANDOWNER <u>Paul Beaugy</u> <u>Omao Rd</u>			
Latitude:			
Longitude: <u>Vanderve, MS</u>			
WELL LOCATION	SEC	TOWNSHIP	RANGE
	<u>34</u>	<u>5 N</u>	<u>7 W</u>
DISTANCE	DIRECTION	NEAREST TOWN	
<u>3</u> Miles	<u>NE</u>	of <u>Vanderve</u>	
OTHER LANDMARK			
WELL PURPOSE: <input checked="" type="radio"/> Home Irrigation, <input type="radio"/> Municipal, <input type="radio"/> Industrial, <input type="radio"/> Fish Pond, etc.			

PUMP DATA	
PUMP TYPE (Circle One): Submersible, Turbine, <input checked="" type="radio"/> Jet, <input type="radio"/> Flowing Well, Other (Describe) _____	
POWER TYPE (Circle One): <input checked="" type="radio"/> Electric, <input type="radio"/> Tractor, <input type="radio"/> Diesel, <input type="radio"/> Gasoline, <input type="radio"/> Butane, Other (Describe) _____ H/P <u>1</u>	

DESCRIPTION OF FORMATIONS ENCOUNTERED	FROM	TO
Top Soil	0	2
Orange Clay	2	78
Brown Coarse Sand	78	30
Orange + White Clay	30	115
Brown Coarse Sand	115	140
Blue Clay	140	230
Grey Medium Sand	230	270

WELL DATA		
Well Depth <u>270'</u>	Casing Diameter (In.) <u>2"</u>	Casing Length (Ft.) <u>200'</u>
Type of Casing <u>PVC</u>	Hole Depth <u>270'</u>	Depth to Static Water Level <u>80'</u>
TYPE OF COMPLETION: (Circle One or More): <input checked="" type="radio"/> Gravel Packed, <input type="radio"/> Underreamed, <input type="radio"/> Telescoped, <input checked="" type="radio"/> Natural Development, <input type="radio"/> Open Hole, <input type="radio"/> Other (Describe) _____		
WELL GROUTED TO A DEPTH OF <u>10</u> FEET Type Grout (circle one): Cement, <input checked="" type="radio"/> Bentonite, or Mix		

SCREEN DATA		
Diameter - Inches <u>2"</u>	Length - Feet <u>10'</u>	Slot Size - Inches <u>.006</u>
Screen Type <u>PVC</u>	Depth to Bottom - Feet <u>270'</u>	

RECEIVED	
FEB 18 2004	
BY: OLWF	
Top of Lap Pipe or Reduction in Casing	IF TELESCOPED OR MORE THAN ONE SCREEN: USE BACK PAGE
FEET	

I certify that the well was drilled, constructed and completed in accordance with all applicable Requirements of the Mississippi Department of Environmental Quality and/or the Mississippi Department of Health regulations and state laws.


Jack Reddell 472
Signature of Licensed Driller and License No.

2/17/04
Date

Additional Information Required On Back

If well telescopes please sketch and show depths.

GROUND LEVEL

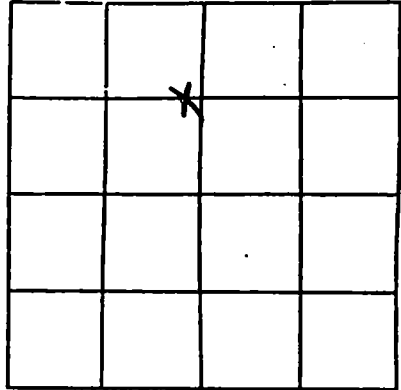

SECTION 34

Please indicate well location X.

Pump Capacity (GPM) 6	No. of Stages 2	Setting Depth FT.
---------------------------------	---------------------------	---------------------------------

PUMP TEST

Well yielded _____ GPM with
a drawdown of _____ ft.
after _____ hours of pumping

LOG DATA

TYPE OF LOG RUN (Circle One): No Log Run,
Electric, Gamma Ray, Density, Sonic, Neutron,
Other (Describe) _____

Name of Organization Running Log _____

GEOLOGIC DATA (Office Use Only)

Surface Elev.	Geologic Unit	Unit Thickness	Depth to Top
Subs. SWL	Date	Analysis	Aquifer Test

Driller's Remarks

If more than one screen,
show location of each on sketch.