

State Well Report

Part 1

Mississippi Department of Environmental Quality
Office of Land and Water Resources
P.O. Box 10631
Jackson, MS 39289-0631
(601)961-5210
(601)354-6938 (fax)

For Office Use Only:

Aquifer: _____
Well #: F-208 059
L. S. Elevation: _____
E-log #: _____

County: Jackson 059
Permit #: _____
Driller: Coast Water Wells Serv
Date drilling completed: 8-27-04

State Law requires that this report be prepared by the driller in detail and filed with the Department within 30 days of completion of drilling of the well.

Well Owner Information	Well Location
Owner Name: <u>Matthew Cochran</u>	Latitude: <u>30° 35' 00"</u> Longitude: <u>088° 38' 35"</u>
Mailing Address: <u>Sampras Drive</u> <u>Sampras Blvd</u>	Method of Lat/Long (circle one): Conventional Survey, <u>44</u>
<u>Vanceleave MS 39565</u> City State Zip Code	USGS quad: <u>Hand-held GPS</u> / Survey-grade GPS <input checked="" type="checkbox"/>
Telephone No. <u>(228) 392-4706</u>	<u>SE</u> 1/4 <u>NE</u> 1/4 Sec. <u>26</u> Twn <u>T5S</u> Rng <u>R7W</u> <u>1R</u> NW <u>25</u> Distance Direction Nearest Town <u>4 1/2</u> Miles <u>NE</u> of <u>Vanceleave</u>

Well Data

Purpose of Well (circle one) Home Industrial Public Supply Irrigation Fish Culture Other: _____

Date well drilling started: 8-26-04 Date well drilling completed: 8-27-04

If flowing, method of flow regulation: Valve N/A Other (describe) _____

Static Water Level: 110 feet above or below (circle one) land surface Date measured: 8-27-04

Method of Measurement (circle one) steel tape electric tape air line other: _____

Hole depth: 266' Well depth: 266' Well grouted to a depth of 10 feet

Type of grout (circle one): Cement Bentonite Mix

Casing length: 256 feet Casing diameter: 2 inches Type of casing: PVC

Screen length: 10 feet Screen diameter: 2 inches Type of screen: PVC

Screen slot size: .006 inches Setting depth: From 256 feet to 266 feet

Type of completion (circle all applicable): Gravel packed Underreamed Telescoped Open hole Natural Development

Other (describe): _____

Top of lap pipe or reduction in casing: N/A feet. If telescoped or more than one screen, describe on back of page

Logs run (circle all applicable): No log run Electric Gamma Ray Density Sonic Neutron Other: _____

Name of organization running log(s): N/A

RECEIVED
SEP 16 2004
BY: OLWR


I certify that the well was drilled, constructed, and completed in accordance with all applicable requirements of the Mississippi Department of Environmental Quality and/or the Mississippi Department of Health regulations and state laws.

Jack Ridgell 0-472 Print Name of Water Well Contractor and License No. Jack Ridgell Signature of Water Well Contractor

F-208

If well telescopes please sketch below and show depths.

Ground Level

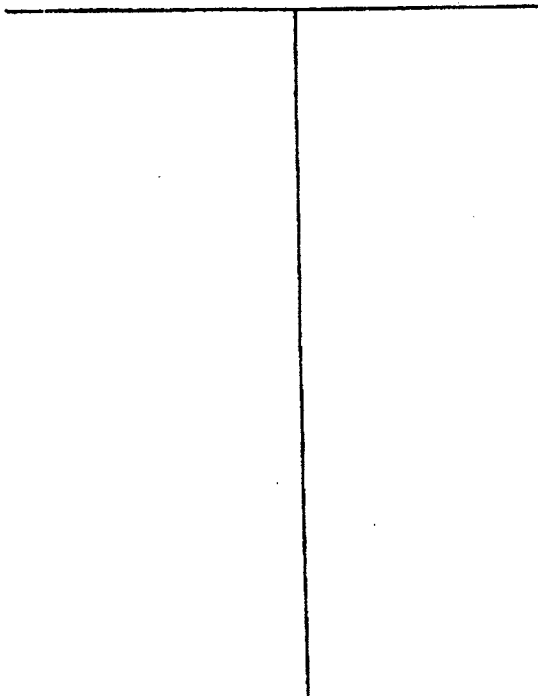


Description of Formations Encountered	From	To
TOPSOIL	0	2
Orange Clay	2	30
Brown Coarse Sand	30	56
Blue Clay	56	196
Gray medium Sand	196	210
Blue Clay	210	250
Gray medium Sand	250	266

If more than one screen, show location of each on sketch

Sketch the property layout and include the following: 1) the well location; 2) any permanent structures on the property that may aid in locating the well; 3) any roads, power lines, or other items that may aid in locating the property and the well; 4) indicate direction.

RECEIVED
SEP 16 2004
BY OLWR

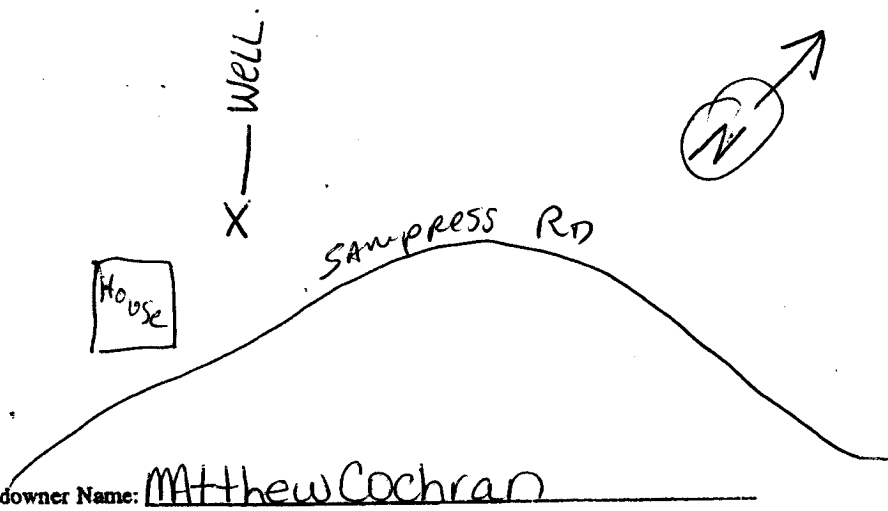

Spnk Ridgdell
Signature of Water Well Contractor

STATE WELL REPORT

Part 2

Pump Installer's Completion Report
 Mississippi Department of Environmental Quality
 Office of Land and Water Resources
 P.O. Box 10631
 Jackson, MS 39289-0631
 (601)961-5210
 (601)354-6938 (fax)

County JACKSON
 Permit #: _____
 Driller: Coast Water Wells Srv
 Date completed: 8-27-04

For Office Use Only:

Aquifer: _____
 Well #: F-208 59
 Elevation: _____

This report should be prepared by the pump installer in detail and filed with the Department within 30 days of the installation of pump.

Well Owner Information	Well Location
Owner Name: <u>Matthew Cochran</u>	Latitude: <u>30°35.004"</u> Longitude: <u>088°38.354"</u>
Mailing Address: <u>Sampress Drive</u>	Method of Lat/Long (circle one): Conventional Survey, USGS quad, <u>Hand-held GPS</u> , Survey-grade GPS
<u>Vanceleave MS 39565</u> City State Zip Code	<u>SE</u> ¼ <u>NE</u> ¼ Sec <u>26</u> Twn <u>T58</u> Rng <u>R7W</u>
Telephone No. <u>228.392-4706</u>	Distance Direction Nearest Town <u>4 1/2</u> Miles <u>NE</u> of <u>Vanceleave</u>

Pump Type Circle one	Power Type Circle one
Air Lift <input checked="" type="radio"/> Jet <input type="radio"/> Submersible	Diesel Engine Gasoline Engine Natural Gas
Bucket <input type="radio"/> Piston <input type="radio"/> Turbine	<input checked="" type="radio"/> Electric Motor <input type="radio"/> Hand <input type="radio"/> Tractor PTO
Centrifugal <input type="radio"/> Rotary <input type="radio"/> Flowing Well	Windmill Other (specify): _____
Other (specify): <u>2 H.P.</u>	Horse Power Rating of Motor: <u>2 H.P.</u>
Date Pump Installed: <u>12-3-04</u>	Setting Depth: <u>Drop pipe 140</u> feet
Rated Pump Capacity: <u>6</u> Gallons Per Minute	Number of Stages: <u>3</u>

Pump Test Data	Method of Measuring Water Level Circle one
Date Well Tested: <u>12-3-04</u>	<input checked="" type="radio"/> Air Line <input type="radio"/> Electric Measuring Line <input type="radio"/> Steel Tape
Static Water Level (A): <u>110</u> Feet Below Land Surface	Other (specify): _____
Pumping Water Level (B): <u>N/A</u> Feet Below Land Surface	For flowing well, measured shut in head: <u>N/A</u> feet
Drawdown [(B) - (A)]: <u>N/A</u> Feet Below Land Surface	Well yielded <u>6</u> GPM with a drawdown of <u>N/A</u> feet after <u>N/A</u> hours of pumping
Test Pumping Rate: <u>6</u> Gallons Per Minute	
Duration of Pump Test (minimum 4 hours): <u>6</u> hours	

I HEREBY CERTIFY that the above statements are true to the best of my knowledge.

David Moyer 0-714P David Moyer
 Print Name of Pump Installer and License No. (if applicable) Signature of Pump Installer