r	State W	ell Report	
County: JACKSON 059		art 1	For Office Use Only:
		t of Environmental Quality	Aquifer:
Permit #:		nd Water Resources	Well #: <u>F-232</u>
Driller Coast Water Wellsrv.	1	Box 10631	
		IS 39289-0631	L. S. Elevation:
Date drilling completed: 3-31-05	(601)961-5210		T 1 #
	j (601)354	4-6938 (fax)	E-log #:
Sast Water Will deriv State Law requires that this rep 30 days of completion of drilling	ort be prepared by the	driller in detail and filed w	ith the Department within
Well Owner Informa		Well	Location
Owner Name_Richard Stuart		Latitude: <u>30.35</u> , <u>77</u>	" Longitude <u>088° 43' 366</u> "
Mailing Address: Campground Rd		A6 Method of Lat/Long (circle one): Conventional Survey,	
		USGS quad, (Hand-held GPS,) Survey-grade GPS	
Vancleave MS 395/65 City State Zip Code		<u>SW 1/4 NE 1/4 Sec 19</u> Twn <u>T55</u> Rng R7W	
Telephone No. (601) 268-2000	Distance Direction		Nearest Town of VANCLEAVE
	Well	Lata	
Purpose of Well (circle one) Home Inc	lustrial Public Supply	Irrigation Fish Culture	Other:
Date well drilling started: 3-31	-05 Date v	vell drilling completed:3_	-31-05
If flowing, method of flow regulation: Va	ive NIA Other (d	escribe)	
	•		
Static Water Level:	bove or below (circle one)	and surface Date measured:	3-31-05
		\frown	
Method of Measurement (circle one) s	teel tape electric tape	(air line) other:	
Hole depth: 125' Well de	pth: 125'	Well grouted to a depth of	10feet
Type of grout (circle one): Cement	Bentonite Mix		
Casing length:feet Casi	ng diameter:		
Screen length: <u>10</u> feet Scre	een diameter:	inches Type of screen:	PVC
Screen slot size: •008 inches	Setting depth: From _	feet to	a5_feet
Type of completion (circle all applicable):	•		hole Natural Development
	Other (describe):		
Top of lap pipe or reduction in casing:	<u> </u>	lescoped or more than one scr	een, describe on back of page
Logs run (circle all applicable): No log ru	Electric Gamma Ray	Density Sonic Neutron	Other:
Name of organization running log(s):	NIA		
I certify that the well was drilled, constr	ructed, and completed in	accordance with all applicable	requirements of the Mississippi
Department of Environmental Quality	and/or the Mississippi De	partment of Health regulation	s and state laws.
Jack Ridadell 0	472	_ Juk	Rifdell
Print Name of Water Well Contractor and	License No.	Signature of	Water Well Continent CEIVI
		ν	APR 2.7 20

÷

٤

,

,

APR 2 7 2005 BY: OLWR If well telescopes please sketch below and show depths.


Ground Level

3

トー ようく	
Description of Formations Encountered	From To
 TODSOIL	$\neg 02$
NADAR DIAL	- K 23
In a right Charg	-1 <u>8,199</u>
Brown Coarsa Sand	- 00 40
White + Orange Clay	40/00
Brown Coarse Sand	/ <i>00</i> /as
······	
	··
·	
	I

~ ~ ~

If more than one screen, show location of each on sketch

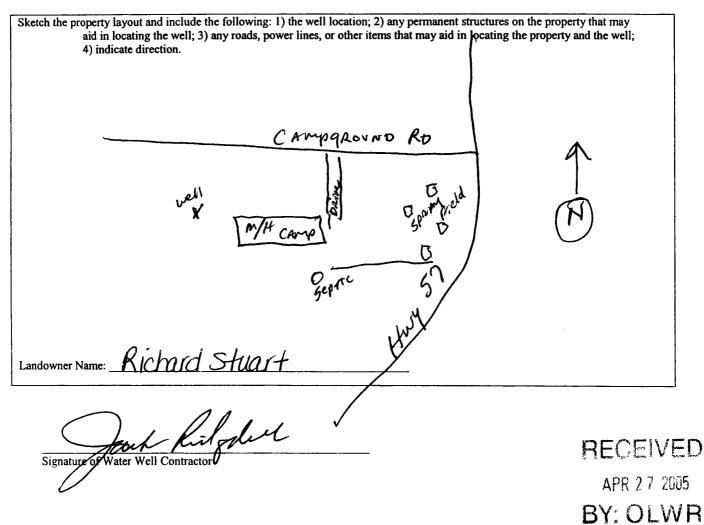

	STATE W	ELL REPORT			
County: JACKSON Permit #: Driller: COAST Water WellSrv Date completed: 3-31-05	Part 2 Pump Installer's Completion Report Mississippi Department of Environmental Quality Office of Land and Water Resources P.O. Box 10631 Jackson, MS 39289-0631 (601)961-5210 (601)354-6938 (fax)		For Office Use Only: Aquifer: Well #: F-232 Elevation:		
This report should be prepared by the installation of pump.			· · · · · · · · · · · · · · · · · · ·		
Well Owner Information		Well Location			
Owner Name: Richard Stua	r+	Latitude: <u>30°35′776</u> Longitude: <u>088°43′366</u>			
Mailing Address: <u>Campground RD</u> <u>Vancleave</u> , <u>MS 39565</u> City State Zip Code		Method of Lat/Long (circle one): Conventional Survey,			
		USGS quad, Hand-held GPS, Survey-grade GPS $\underline{SW} \ \underline{NE} \ \underline{NE} \ \underline{Sec} \ \underline{I9} \ \underline{Twn} \ \underline{T5S} \ \underline{Rng} \ \underline{R7W}$ Distance Direction Nearest Town			
				5 Miles NW of Vorcleave	
				Telephone No. $(\underline{UU}) \otimes \underline{US} = \otimes \underline{UU}$.0
		Pump Type Circle one		Power Type Circle one	
Air Lift Jet	Submersible	Diesel Engine Gasolin	e Engine Natural Gas		
Bucket Piston	Turbine	(Electric Motor) Hand	Tractor PTO		
			(specify):		
Centrifugal Rotary Flowing Well Other (specify):			_ 1 HP Gould		
Date Pump Installed: 4-2-05 Rated Pump Capacity: 8 Gallons Per Minute		Setting Depth: 60' Droppipe) feet			
Rated Pump Capacity: 0	_Gallons Per Minute	Number of Stages:	×		
Pump Test Data			asuring Water Level		
Date Well Tested:			ircle one		
Static Water Level (A):Feet Below Land Surface		Air Line Electric Mea	suring Line Steel Tape		
Pumping Water Level (B): N A Feet Below Land Surface		Other (specify):			
	Delow Land Sullace				
		For flowing well, measured sh	ut in head: N/A feet		
Drawdown [(B) – (A)]: N/A Feet	Below Land Surface		tut in head: $\frac{\sqrt{2}}{2}$ feet		
	Below Land Surface Gallons Per Minute	Well yielded 8			
Drawdown [(B) – (A)]: N/A Feet Test Pumping Rate: 8 Duration of Pump Test (minimum 4 hours):	Below Land Surface Gallons Per Minute	Well yielded	GPM with a drawdown of		
Drawdown [(B) – (A)]: N/A Feet Test Pumping Rate: 8	Below Land Surface Gallons Per Minute	Well yielded	GPM with a drawdown of		
Drawdown [(B) – (A)]: <u>N/A</u> Feet Test Pumping Rate: <u>8</u> Duration of Pump Test (minimum 4 hours):	Below Land Surface Gallons Per Minute hours 	Well yielded	$GPM with a drawdown of N/A_hours of pumping$		

•

N 4 .

٠

BY: OLWR