county Jackson	State Well		
County Juck SOL	Part	- 1	For Office Use Only:
	Mississippi Department of	Environmental Quality	Aquifer:
Permit #:	Office of Land and V P.O. Box		Well #: F- 244
Driller COOST WATER Wellsev	Jackson, MS 3	9289-0631	L. S. Elevation:
Date drilling completed: <u>6-20-05</u>	(601)961-5210 (601)354-6938 (fax)		E-log #:
State Law requires that this repo		ler in detail and filed w	ith the Department within
30 days of completion of drilling Well Owner Informa		Well	Location
Dwner Name Rayford Keen	44		
Mailing Address: 1640101d River Rel. Loop Method of Lat/Long (circle one): Conventional Survey,			
		USGS quad, Hand-held	GPS, Survey-grade GPS
	MCLEAVE MS 39565 SW 1/2 NW 1/2 Sec 40		_Twn <u>T5S</u> RngR7W
Felephone No. 228 826-53	Distance Direction		Nearest Town of Vanicleance
	Well Data		
Purpose of Well (circle one) Home Inde	ustrial Public Supply Irr	igation Fish Culture	Other:
Date well drilling started: 6-20-0	-	- -	
f flowing, method of flow regulation: Val	ve Other (descri	be)	<u></u>
Static Water Level: <u>85</u> feet ab	ove or below (circle one) land	surface Date measured:_	6-20-05
Method of Measurement (circle one) st	eel tape electric tape	air line other:	
Hole depth: <u>200</u> ′ Well dep	oth: <u>200'</u> w	/ell grouted to a depth of	feet
Type of grout (circle one): Cement	Bentonite Mix		•
Casing length: <u>190</u> feet Casin	ng diameter: <u>2</u> in	ches Type of casing:	PVC
Screen length: <u>10</u> feet Scree	en diameter: <u> </u>	ches Type of screen:	PVC
001		90feet to	00 feet
Type of completion (circle all applicable):			hole Natural Development
	Other (describe):		
Fop of lap pipe or reduction in casing:	N/Afeet. If telesco	ped or more than one scr	een, describe on back of page
Logs run (circle all applicable) No log run	Electric Gamma Ray De	ensity Sonic Neutron	Other:
	V/A		
certify that the well was drilled, constru-	-		•
Department of Environmental Quality a	nd/or the Mississippi Depart	ment of Health regulations	and state laws.
Jack Ridadell D4	12	Joh	, Kilyfill

JUN 27 2005 BY: OLWR If well telescopes please sketch below and show depths.


F244

Ground Le

Y

Jevel	Description of Formations Encountered	From To
	Drange Clay Brown Coarse Sand Blue Clay Gray Medium Sand	3 /7 /7 35 35 /87 187 200
	L	

If more than one screen, show location of each on sketch

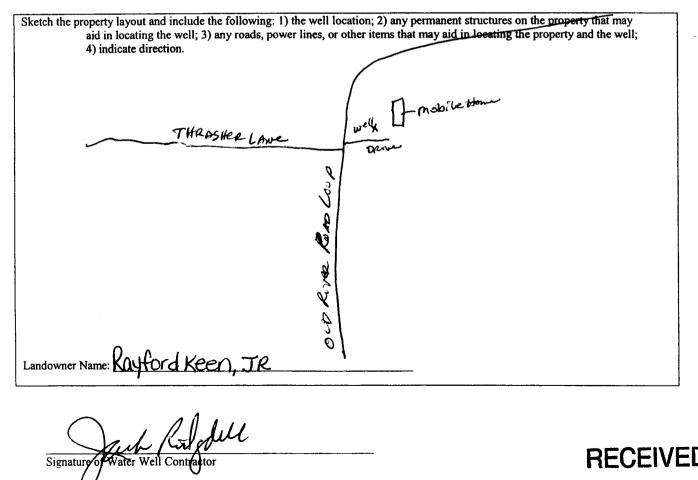

RECEIVED JUN 27 2005 **BY: OLWR**

STATE WELL REPORT						
County: <u>JackSOn</u> Permit #: Driller: <u>Cast Water WellSrv</u> Date completed: <u>6-20-05</u>	Part 2 Pump Installer's Completion Report Mississippi Department of Environmental Quality Office of Land and Water Resources P.O. Box 10631 Jackson, MS 39289-0631 (601)961-5210 (601)354-6938 (fax)		For Office Use Only: Aquifer: Well #: F- Copp 24			
This report should be prepared by the pump installer in detail and filed with the Department within 30 days of the installation of pump.						
Well Owner Informat		Well Location				
Owner Name: Kayford Keen		Latitude: 30°34' 746" Longitude: 088'38' 250"				
Mailing Address: 1640101d RIVE	r Rd Loop	Method of Lat/Long (circle one): Conventional Survey,				
		USGS quad, Hand-held GPS Survey-grade GPS				
Vancleave MS 39565 City State Zip Code Telephone No. (288 826 - 5333		<u>אי אי אי Sec 4 כ</u> Distance Direction <u>4/2</u> Miles <u>NF</u> or	D_Twn_TSS_Rng_R7W Nearest Town f_VAncleane			
Pump Type Circle one		1	wer Type ircle one			
Air Lift Jet	Submersible	Diesel Engine Gasolin	e Engine Natural Gas			
Bucket Piston	Turbine	Electric Motor Hand	Tractor PTO			
Centrifugal Rotary	Flowing Well	Windmill Other (specify):			
Other (specify):		Horse Power Rating of Motor:	2 HP Gouldo			
Date Pump Installed: <u>7-12-05</u>		Setting Depth: 120FT. Droppipe, feet				
Rated Pump Capacity: 8		Number of Stages:3				
Pump Test Data		Method of Measuring Water Level Circle one				
Date Well Tested: <u>7 - 12 - 05</u> Static Water Level (A): <u>85</u> Feet Below Land Surface Pumping Water Level (B): <u>N/A</u> Feet Below Land Surface			suring Line Steel Tape			
Drawdown [(B) - (A)]: NA Feet Below Land Surface		For flowing well, measured sh	nut in head: <u>N/A</u> feet			
Test Pumping Rate: Gallons Per Minute		Well yielded GPM with a drawdown of				
Duration of Pump Test (minimum 4 hours):	<u> </u>	N/A feet after				
I HEREBY CERTIFY that the above staten Ben Ridadell 0-71 Print Name of Pump Installer and License 1	38	of my knowledge. <u>BR</u> Signature of Pump Iz				
TIUR MAINE OF FUTTIE HISTARIEL AND ELCENSE I		orginature or r allip ip	TEVLIVED			

• [•] •

.

AUG 0 1 2005 BY: OLWR