	State We	ell Report	
County: Jackson	Part 1		For Office Use Only:
•	Mississippi Department of Environmental Quality		Aquifer:
Permit #: $(1) = \frac{1}{2} \frac{1}$	Office of Land and Water Resources P.O. Box 10631		Well #: F-278
Driller: Clast Water Well SRV.		39289-0631	L. S. Elevation:
Date drilling completed: 5-17-06		61-5210	
	(601)354-	6938 (fax)	E-log #:
State Law requires that this rep- 30 days of completion of drilling		riller in detail and filed w	ith the Department within
Well Owner Informa		Well	Location
Owner Name Kenneth Rice	Latitude: 30.35, 7		" Longitude 088. 38 , 584
Mailing Address: River Place	Derre	A8 Method of Lat/Long (circle on	26
		USGS quad, Hand-held GPS, Survey-grade GPS	
Vancleave Ms 39565		NW 1/ SE 1/2 Sec 24 Twn 755 RngR 7W	
City State Zip Code			
Telephone No. (208) 873-619	98 Distance Direction		of Vancleave
	Well Da	nta	
Purpose of Well (circle one Home Ind	ustrial Public Supply	Initiation Fish Children	04
Furbose of wentencie ond nome / ma			
	11 2	Irrigation Fish Culture	Other:
	11 2	-	<u>ب من بر بر من </u>
Date well drilling started: 5-17-0	Date we	Il drilling completed:5	<u>ب من بر بر من </u>
Date well drilling started: 5-17-C	Vo Date we ve N/A Other (des	Il drilling completed:5	-17-06
Date well drilling started: If flowing, method of flow regulation: Val Static Water Level:feet ab	Date we ve <u>NA</u> Other (des ove of below) (circle one) lar	all drilling completed:5	-17-06
Date well drilling started: 5-17-0 If flowing, method of flow regulation: Val Static Water Level: 100 feet ab Method of Measurement (circle one) st	Date we ve Date we ve Other (des ove of below)(circle one) lar eel tape electric tape	air line other:	5-17-06 5-17-06 RECEI
Date well drilling started: If flowing, method of flow regulation: Val Static Water Level:feet ab	Date we ve Date we ve Other (des ove of below)(circle one) lar eel tape electric tape	all drilling completed:5	5-17-06 5-17-06 RECEI
Date well drilling started: 5-17-0 If flowing, method of flow regulation: Val Static Water Level: 100 feet ab Method of Measurement (circle one) st	Date we ve Date we ve Other (des ove of below)(circle one) lar eel tape electric tape	air line other:	5-17-06 5-17-06 RECEI
Date well drilling started: <u>5-17-6</u> If flowing, method of flow regulation: Val Static Water Level: <u>100</u> feet ab Method of Measurement (circle one) st Hole depth: <u>201</u> Well dep Type of grout (circle one): Cement	Date we Date we $N/A$ Other (des ve $N/A$ Other (des vove of below) (circle one) lar eel tape electric tape oth: $30/'$ Bentonite Mix	air line other:	5-17-06 5-17-06 RECE
Date well drilling started: If flowing, method of flow regulation: Val Static Water Level: feet ab Method of Measurement (circle one) st Hole depth: Well dep Type of grout (circle one): Cement (Casing length: feet Casing length:	Date we Date we Date we Date we Date we Dother (des prove of below) (circle one) lar eel tape electric tape pth: $\frac{201'}{100}$ Bentonite Mix ag diameter: $\frac{2}{100}$	Il drilling completed:S cribe) ad surface Date measured: air line other: Well grouted to a depth of inches Type of casing:	5-17-06 5-17-06 RECEI
Date well drilling started: If flowing, method of flow regulation: Val Static Water Level: feet ab Method of Measurement (circle one) st Hole depth: Well dep Type of grout (circle one): Cement ( Casing length: feet Casin Screen length: feet Screen	Date we ve Date we ve Other (des ove of below (circle one) lar eel tape electric tape oth: Bentonite Mix ag diameter: en diameter:	Il drilling completed:S cribe) ad surface Date measured: air line other: Well grouted to a depth of inches Type of casing: inches Type of screen:	<u>5-17-06</u> <u>5-17-06</u> <u>RECEI</u> <u>10</u> <u>fect</u> <u>JUN 152</u> <u>PVC</u> <u>PVC</u> <u>PVC</u>
Date well drilling started: If flowing, method of flow regulation: Val Static Water Level: feet ab Method of Measurement (circle one) st Hole depth: Well dep Type of grout (circle one): Cement (Casing length: feet Casin Screen length: feet Casin Screen slot size: OO8 inches	Date we ve Date we ve Other (des ove of below (circle one) lar eel tape electric tape oth: Bentonite Mix ag diameter: en diameter: Setting depth: From	Il drilling completed:S cribe) ad surface Date measured: air line other: Well grouted to a depth of inches Type of casing: inches Type of screen: feet to2	<u>5-17-06</u> <u>5-17-06</u> <u>10</u> <u>fect</u> <u>JUN 152</u> <u>PVC</u> <u>BY: OLV</u> <u>PUC</u> <u>01</u> <u>fect</u>
Date well drilling started: If flowing, method of flow regulation: Val Static Water Level: feet ab Method of Measurement (circle one) st Hole depth: Well dep Type of grout (circle one): Cement ( Casing length: feet Casin Screen length: feet Screen	Date we ve Date we ve Other (des ove of below (circle one) lar eel tape electric tape oth: Bentonite Mix ag diameter: en diameter: Setting depth: From Gravel packed Underre	Il drilling completed:S cribe) ad surface Date measured: air line other: Well grouted to a depth of inches Type of casing: inches Type of screen: feet to2	<u>5-17-06</u> <u>5-17-06</u> <u>RECEI</u> <u>10</u> <u>fect</u> <u>JUN 152</u> <u>PVC</u> <u>PVC</u> <u>PVC</u>
Date well drilling started: If flowing, method of flow regulation: Val Static Water Level: feet ab Method of Measurement (circle one) st Hole depth: Well dep Type of grout (circle one): Cement ( Casing length: feet Casin Screen length: feet Scree Screen slot size: OOS inches Type of completion (circle all applicable):	Date we ve Date we ve Other (des ove of below (circle one) lar eel tape electric tape oth: Bentonite Mix ag diameter: en diameter: Setting depth: From Gravel packed Underree Other (describe):	Il drilling completed:	$\frac{5-17-06}{5-17-06}$ $\frac{10}{10}$
Date well drilling started: If flowing, method of flow regulation: Val Static Water Level: feet ab Method of Measurement (circle one) st Hole depth: Well dep Type of grout (circle one): Cement ( Casing length: feet Casin Screen length: feet Scree Screen slot size: OOS inches Type of completion (circle all applicable):	Date we ve Date we ve Other (des ove of below (circle one) lar eel tape electric tape oth: Bentonite Mix ag diameter: en diameter: Setting depth: From Gravel packed Underree Other (describe):	Il drilling completed:	<u>5-17-06</u> <u>5-17-06</u> <u>10</u> <u>fect</u> <u>JUN 152</u> <u>PVC</u> <u>BY: OLV</u> <u>PUC</u> <u>01</u> <u>fect</u>
Date well drilling started: If flowing, method of flow regulation: Val Static Water Level: feet ab Method of Measurement (circle one) st Hole depth: Well dep Type of grout (circle one): Cement ( Casing length: feet Casin Screen length: feet Scree Screen slot size: OOS inches Type of completion (circle all applicable):	Date we ve Date we ve Other (des rove of below (circle one) lar eel tape electric tape oth: Bentonite Mix ag diameter: en diameter: Setting depth: From Gravel packed Underree Other (describe): <u>J/A</u> feet. If teles	Il drilling completed:	$\frac{5-17-06}{5-17-06}$ $\frac{5-17-06}{PECEI}$ $\frac{10}{10}$ $\frac{10}{feet}$ $\frac{10}{10}$ $\frac{10}{10$
Date well drilling started: If flowing, method of flow regulation: Val Static Water Level: feet ab Method of Measurement (circle one) st Hole depth: Well dep Type of grout (circle one): Cement (Casing length: feet Casin Screen length: feet Casin Screen slot size: OO8 inches Type of completion (circle all applicable): Top of lap pipe or reduction in casing: Logs run (circle all applicable: No log run Name of organization running log(s):	Date we ve Date we ve Other (des rove of below (circle one) lar eel tape electric tape oth: Bentonite Mix ag diameter: g diameter: en diameter: Setting depth: From Gravel packed Underre Other (describe): DIAfeet. If teles D Electric Gamma Ray N/A	Id drilling completed:      S         acribe)          and surface       Date measured:         air line       other:          Well grouted to a depth of          inches       Type of casing:          inches       Type of screen:	5-17-06 5-17-06 PECEI JUN 152 PVC BY: OLV PVC 01 feet hole Natural Development een, describe on back of page Other:
Date well drilling started: If flowing, method of flow regulation: Val Static Water Level: Method of Measurement (circle one) st Hole depth: Type of grout (circle one): Cement ( Casing length: Screen length: Screen slot size: Screen slot size: Screen slot size: Type of completion (circle all applicable): Top of lap pipe or reduction in casing: Logs run (circle all applicable: No log run Name of organization running log(s): I certify that the well was drilled, constr	Date we ve Date we ve Other (des ove of below (circle one) lar eel tape electric tape oth: Bentonite Mix ag diameter: g diameter: en diameter: Setting depth: From Gravel packed Underree Other (describe): J/Afeet. If teles Difference for the set of the se	Il drilling completed:	5-17-06 5-17-06 RECEI JUN 152 PVC BY; OLV PVC 01 feet hole Natural Development een, describe on back of page Other:
Date well drilling started: If flowing, method of flow regulation: Val Static Water Level: feet ab Method of Measurement (circle one) st Hole depth: Well dep Type of grout (circle one): Cement (Casing length: feet Casin Screen length: feet Casin Screen slot size: OO8 inches Type of completion (circle all applicable): Top of lap pipe or reduction in casing: Logs run (circle all applicable: No log run Name of organization running log(s):	Date we ve Date we ve Other (des ove of below (circle one) lar eel tape electric tape oth: Bentonite Mix ag diameter: g diameter: en diameter: Setting depth: From Gravel packed Underree Other (describe): J/Afeet. If teles Difference for the set of the se	Il drilling completed:	5-17-06 5-17-06 RECEI JUN 152 PVC BY; OLV PVC 01 feet hole Natural Development een, describe on back of page Other:
Date well drilling started: If flowing, method of flow regulation: Val Static Water Level: Method of Measurement (circle one) st Hole depth: Type of grout (circle one): Cement ( Casing length: Casing length: Screen length: Screen slot size: Screen slot size: Screen slot size: Type of completion (circle all applicable): Top of lap pipe or reduction in casing: Logs run (circle all applicable: No log run Name of organization running log(s): I certify that the well was drilled, constr	Date we ve Date we ve Other (des ove of below (circle one) lar eel tape electric tape oth: Bentonite Mix ag diameter: g diameter: en diameter: Setting depth: From Gravel packed Underree Other (describe): J/Afeet. If teles Difference for the set of the se	Il drilling completed:	5-17-06 5-17-06 RECEN JUN 15 BY: OLV PVC OI feet hole Natural Development een, describe on back of page Other:

If well telescopes please sketch below and show depths.


F-278

Ground Level

13

 Description of Formations Encountered	From	To A
White Coarse Sand Blue Clay Gray Coarse Sand	94	T&
Gray Coarse Sand	185	20Ĭ
	I	L

If more than one screen, show location of each on sketch

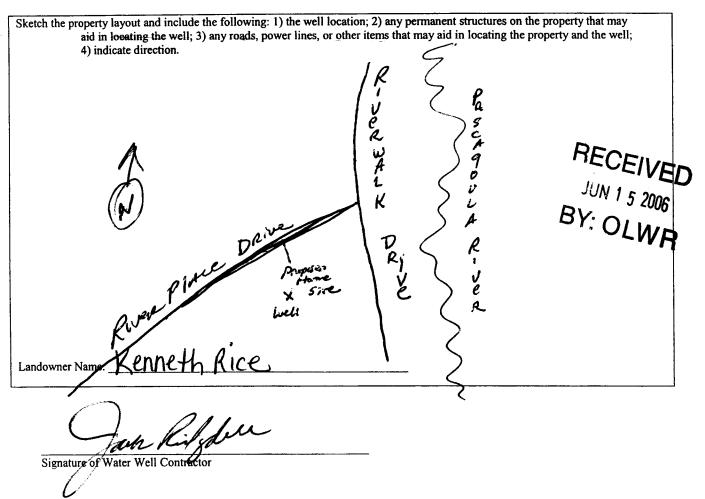

	STATE WI	ELL REPORT		
County: JOCKSON Permit #: Driller: COASH WATER WEISEV. Date completed: 5-17-06	Pump Installer' Mississippi Departmen Office of Land P.O. J Jackson, M (601	Part 2 s Completion Report nt of Environmental Quality and Water Resources Box 10631 MS 39289-0631 )961-5210 54-6938 (fax)	For Office Use Only: Aquifer: Well #: F - 298 Elevation:	
This report should be prepared by th	e pump installer in deta			
installation of pump. Well Owner Information Owner Name: Kenneth Rice Mailing Address: Rever Place Drove <u>Vancleave Ms 39565</u> City State Zip Code Telephone No. (208) 812 - 6198		Well Location         Latitude: 30° 35′ 799 "Longitude: 088° 38′ 584 "         Method of Lat/Long (circle one): Conventional Survey,         USGS quad, Hand-held GPS         Survey-grade GPS         M ¼ 5€ ¼ Sec 24 Twn 755 Rng R 1W         Distance       Direction         Nearest Town         5 1/2 Miles NE of		
Pump Type Circle one		Por	wer Type ircle one	
Pumping Water Level (B):Feet	Gallons Per Minute	Plectric Motor Hand Windmill Other ( Horse Power Rating of Motor: Setting Depth: DOFT.D Number of Stages: Method of Me C Air Line Electric Mea Other (specify):	A COPPIPE feet 3 RECEIVE asuring Water Lifel/ 5 2006 ircle one BY: Oct TAPR	
Drawdown [(B) – (A)]:Feet Test Pumping Rate: Duration of Pump Test (minimum 4 hours):	Gallons Per Minute	For flowing well, measured sh Well yielded	Lut in head:feet GPM with a drawdown of Ahours of pumping	
I HEREBY CERTIFY that the above statem JOCK RIDGOUL D-4 Print Name of Pump Installer and License N	72	of my knowledge. Signature of Pump In	fdeu Istaller	

\* . . . . \*