State	Well Report				
Contra TACKSON	Part 1	For Office Use Only:			
Mississippi Departi	ment of Environmental Quality nd and Water Resources	Aquifer: Well #: F-284			
	O. Box 10631	Well #: <u>F-284</u>			
Jackso.	n, MS 39289-0631	L. S. Elevation:			
	501)961-5210)354-6938 (fax)	E-log #:			
State Law requires that this report be prepared by	the driller in detail and filed y	with the Department within			
30 days of completion of drilling of the well.					
Well Owner Information	on Well Location				
Owner Name Carpoll Clifford	Latitude: <u>30 • 34</u> <u>'385</u> " Longitude: <u>088</u> •				
Mailing Address: Black Foot Bd	Method of Lat/Long (circle o	one): Conventional Survey, 11			
	USGS quad Hand-held GPS, Survey-grade GPS				
<u>VANCIEAVE MS 39565</u> City State Zip Code	z Zip Code				
Telephone No. 2013337-0111	Distance Discretion Mennet Term				
W	/ell Data				
Purpose of Well (circle one) Home Industrial Public Supp	ly Irrigation Fish Culture	Other:			
Date well drilling started: $0 - 10 - 00$ D	ate well drilling completed:	7-06			
If flowing, method of flow regulation: Valve VA Oth	er (describe)				
Static Water Level:feet above or below circle o	ne) land surface Date measured:	6-7-06			
Method of Measurement (circle one) steel tape electric	tape (air line) other:				
Hole depth: 336 Well depth: 336	Well grouted to a depth of	<u>10</u> feet			
Type of grout (circle one): Cement Bentonite	Иix				
Casing length: 321 feet Casing diameter: 2 inches Type of casing: DVC					
Screen length: <u>15</u> feet Screen diameter: $\hat{2}$	inches Type of screen:	DVC			
Screen slot size: <u>• 008</u> inches Setting depth: From <u>321</u> feet to <u>336</u> feet					
Type of completion (circle all applicable): Gravel packed Underreamed Telescoped Open hole Natural Development					
Other (describe):					
	If telescoped or more than one sci				
Logs run (circle all applicable) No log run Electric Gamma	Ray Density Sonic Neutron	Other:			
Name of organization running log(s): NIA					
I certify that the well was drilled, constructed, and completed	in accordance with all applicable	e requirements of the Mississippi			
Department of Environmental Quality and/or the Mississippi	Department of Health regulation	is and state laws.			
Jack Ridgadell 0-472	Ja	e requirements of the Mississippi as and state laws. <u>Harden Kiljen (CEII)</u> f Water Well Copyrector (CEII) f Water (CEII) f Water (CEIII) f Water (CEII) f Water (CEIII) f Water (CEIII) f Water (CEIII) f Water (CEIII) f Water (CEIII) f Water (CEIII)			
Print Name of Water Well Contractor and License No.	Signature o	f Water Well Contractor			
		~ WN			
		· • • •			

٠

ц (т. т. т.


1=-284

If well telescopes please sketch below and show depths.

Ground Level

Description of Formations Encountered	From	То
 TOPSOIL	<u> </u>	à
Brown coarse sand		3
Bueclau	32	22
Bray course sand	183	194
Blue clau	194	284
Gray course sand	- 284	336
V		
·····		
1		
]
······································		
	_	
L		

If more than one screen, show location of each on sketch

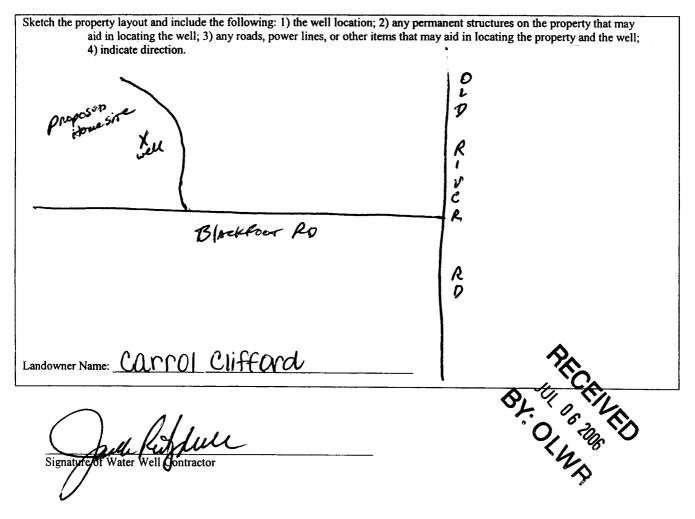

STATE WELL REPORT						
County: Jackson_	Part 2 Pump Installer's Completion Report Mississippi Department of Environmental Quality Office of Lond and Water Resources		For Office Use Only: Aquifer:			
Driller: COOST WATEr Well St Date completed: 6-7-06	P.O. Box 10631 Jackson, MS 39289-0631 (601)961-5210		well #: _ F - & 84			
Date completed: <u><u><u><u></u></u><u><u><u></u><u></u><u><u></u><u></u><u><u></u><u><u></u></u><u></u><u><u></u><u></u><u></u><u></u><u></u><u></u></u></u></u></u></u></u></u>	(601)354-6938 (fax)		Elevation:			
This report should be prepared by the installation of pump.	This report should be prepared by the pump installer in detail and filed with the Department within 30 days of the					
Well Owner Informa	· · · · · · · · · · · · · · · · · · ·		Location			
Owner Name: Carroll Clifford			"Longitude: 08 37 190 "			
Mailing Address: BLOCKFOOT RC	Method of Lat/Long (circle on		e): Conventional Survey,			
		USGS quad, Hand-	held GPS Survey-grade GPS			
Vancleave MS 39565 NE		<u>NE 1/ NE 1/ Sec 35</u>	NE 1/2 NE 1/2 Sec 35 Twn T55 Rng R7W			
City State	Distance Direction		Nearest Town			
Telephone No. <u>228</u> , <u>327-0/17</u> <u>4</u> Miles <u>NE</u> or		Vavclette				
D		ـــــــــــــــــــــــــــــــــــــ				
Pump Type Circle one			ver Type rcle one			
Air Lift Jet	Submersible	Diesel Engine Gasoline	e Engine Natural Gas			
Bucket Piston	Turbine	Electric Motor Hand	Tractor PTO			
Centrifugal Rotary	Flowing Well		specify):			
Other (specify):		Horse Power Rating of Motor:	Horse Power Rating of Motor:			
Date Pump Installed:	Date Pump Installed: 6-20-06		Setting Depth: 120FT. Drop pipe feet			
Rated Pump Capacity:	Gallons Per Minute	Number of Stages:3				
Pump Test Data		Method of Measuring Water Level				
Date Well Tested: 0-20-06			rcle one			
Static Water Level (A): 55 Feet Below Land Surface			uring Line Steel Tape			
Pumping Water Level (B): N/A Feet Below Land Surface Other (specify):						
Drawdown [(B) – (A)]:Feet Below Land Surface For flowing well, measured shut in head:			it in head: <u>N/A</u> feet			
Test Pumping Rate: Gallons Per Minute Well yielded 9		GPM with a drawdown of				
Duration of Pump Test (minimum 4 hours):	<u>5/z</u> hours	N/Afeet after	N/A_hours of pumping			
· · · · · · · · · · · · · · · · · · ·						
I HEREBY CERTIFY that the above statements are true to the best of my knowledge. JOCK Ridgdell 0-472 Print Name of Pump Installer and License No. (if applicable) Signature of Pump Installer						
Print Name of Pump Installer and License N	lo. (if applicable)	Signature of Pump Inc	taller . 6			
			°∕∧			

`**`**