

State Well Report

Part 1

Mississippi Department of Environmental Quality
Office of Land and Water Resources
P.O. Box 10631
Jackson, MS 39289-0631
(601)961-5210
(601)354-6938 (fax)

For Office Use Only:

Aquifer: _____
Well #: F-302
L. S. Elevation: _____
E-log #: _____

County: JACKSON
Permit #: _____
Driller: Coast Water Well Serv.
Date drilling completed: 10-14-06

State Law requires that this report be prepared by the driller in detail and filed with the Department within 30 days of completion of drilling of the well.

| Well Owner Information | Well Location |
|---|---|
| Owner Name: <u>Lee Farragut</u> | Latitude: <u>30° 35' 32.5"</u> Longitude: <u>088° 38' 02.5"</u> |
| Mailing Address: <u>River Place Dr.</u> | Method of Lat/Long (circle one): <u>Conventional Survey</u> |
| <u>Vanderve, MS 39565</u> | USGS quad, <u>(Hand-held GPS)</u> , Survey-grade GPS |
| City State Zip Code | <u>SE 1/4 NW 1/4 Sec 24 Twn T5S Rng R7W</u> |
| Telephone No. <u>(228) 990-7217</u> | Distance Direction Nearest Town |
| | <u>5 Miles NE of VANDERVE</u> |

Well Data

Purpose of Well (circle one) Home Industrial Public Supply Irrigation Fish Culture Other: _____

Date well drilling started: 10-14-06 Date well drilling completed: 10-14-06

If flowing, method of flow regulation: Valve NIA Other (describe) _____

Static Water Level: 100 feet above or below (circle one) land surface Date measured: 10-14-06

Method of Measurement (circle one) steel tape electric tape air line other: _____

Hole depth: 200' Well depth: 200' Well grouted to a depth of 10 feet

Type of grout (circle one): Cement Bentonite Mix

Casing length: 190 feet Casing diameter: 2 inches Type of casing: PVC

Screen length: 10 feet Screen diameter: 2 inches Type of screen: PVC

Screen slot size: 006 inches Setting depth: From 190 feet to 200 feet

Type of completion (circle all applicable): Gravel packed Underreamed Telescoped Open hole Natural Development

Other (describe): _____

Top of lap pipe or reduction in casing: _____ feet. If telescoped or more than one screen, describe on back of page

Logs run (circle all applicable): No log run Electric Gamma Ray Density Sonic Neutron Other: _____

Name of organization running log(s): NIA

I certify that the well was drilled, constructed, and completed in accordance with all applicable requirements of the Mississippi Department of Environmental Quality and/or the Mississippi Department of Health regulations and state laws.

Jack Ridgdell 0-472

Print Name of Water Well Contractor and License No.

Jack Ridgdell
Signature of Water Well Contractor

RECEIVED

NOV 09 2006

BY: OLWR

If well telescopes please sketch below and show depths.


Ground Level

A large empty rectangular box for sketching well telescopes and depths.

| Description of Formations Encountered | From | To |
|---------------------------------------|------|-----|
| Top Soil | 0 | 2 |
| white coarse sand | 2 | 60 |
| orange clay | 60 | 195 |
| Gray medium sand | 195 | 200 |
| | | |
| | | |
If more than one screen, show location of each on sketch

Sketch the property layout and include the following: 1) the well location; 2) any permanent structures on the property that may aid in locating the well; 3) any roads, power lines, or other items that may aid in locating the property and the well; 4) indicate direction.

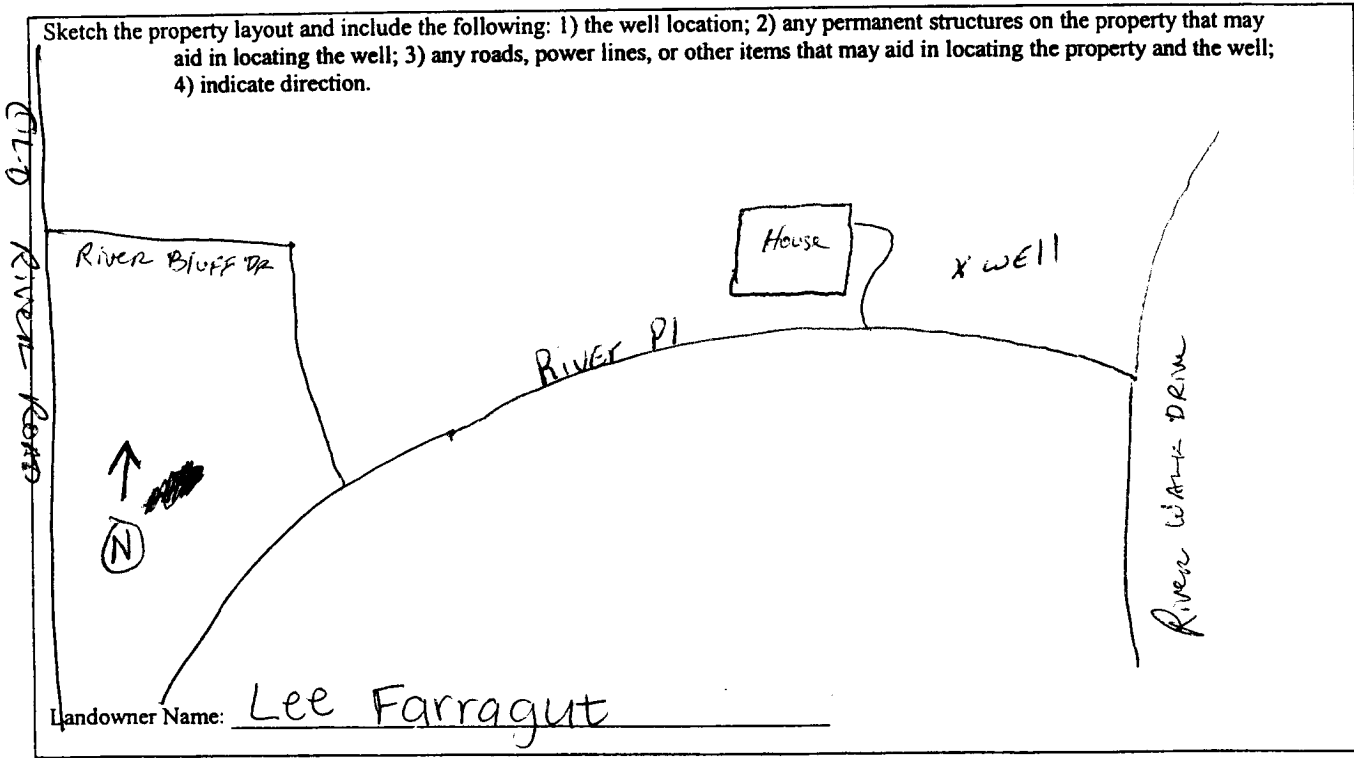

RECEIVED
 NOV 09 2006
 BY: OLWR

 Signature of Water Well Contractor

STATE WELL REPORT

Part 2

Pump Installer's Completion Report
 Mississippi Department of Environmental Quality
 Office of Land and Water Resources
 P.O. Box 10631
 Jackson, MS 39289-0631
 (601)961-5210
 (601)354-6938 (fax)

For Office Use Only:

Aquifer: _____

Well #: F-302

Elevation: _____

County: JACKSON
 Permit #: _____
 Driller: Coast Water Wells SRV.
 Date completed: 10-14-06

This report should be prepared by the pump installer in detail and filed with the Department within 30 days of the installation of pump.

| Well Owner Information | Well Location |
|--|---|
| Owner Name: <u>Lee Faragut</u> | Latitude: <u>30°35'325"</u> Longitude: <u>088°38'425"</u> |
| Mailing Address: <u>River Place Dr.</u> | Method of Lat/Long (circle one): Conventional Survey, USGS quad, <u>(Hand-held GPS)</u> Survey-grade GPS |
| <u>Vanceleave, MS 39565</u> City State Zip Code | <u>SE 1/4 NW 1/4 Sec 24 Twn T5S Rng R7W</u> |
| Telephone No. <u>228 990-7217</u> | Distance Direction Nearest Town <u>5 Miles NE of VANCELEAVE</u> |

| Pump Type Circle one | Power Type Circle one |
|---|---|
| Air Lift <input type="radio"/> <u>Jet</u> <input type="radio"/> Submersible | Diesel Engine <input type="radio"/> Gasoline Engine <input type="radio"/> Natural Gas |
| Bucket <input type="radio"/> Piston <input type="radio"/> Turbine | <u>Electric Motor</u> <input type="radio"/> Hand <input type="radio"/> Tractor PTO |
| Centrifugal <input type="radio"/> Rotary <input type="radio"/> Flowing Well | Windmill <input type="radio"/> Other (specify): _____ |
| Other (specify): _____ | Horse Power Rating of Motor: <u>2 HP</u> |
| Date Pump Installed: <u>10-18-06</u> | Setting Depth: <u>120' Ft. drop pipe</u> feet |
| Rated Pump Capacity: <u>7</u> Gallons Per Minute | Number of Stages: <u>3</u> |

| Pump Test Data | Method of Measuring Water Level Circle one |
|---|--|
| Date Well Tested: <u>10-18-06</u> | <u>Air Line</u> <input type="radio"/> Electric Measuring Line <input type="radio"/> Steel Tape <input type="radio"/> |
| Static Water Level (A): <u>100</u> Feet Below Land Surface | Other (specify): _____ |
| Pumping Water Level (B): <u>N/A</u> Feet Below Land Surface | For flowing well, measured shut in head: <u>N/A</u> feet |
| Drawdown [(B) - (A)]: <u>N/A</u> Feet Below Land Surface | Well yielded <u>7</u> GPM with a drawdown of |
| Test Pumping Rate: <u>7</u> Gallons Per Minute | <u>N/A</u> feet after <u>N/A</u> hours of pumping |
| Duration of Pump Test (minimum 4 hours): <u>4</u> hours | |

I HEREBY CERTIFY that the above statements are true to the best of my knowledge.

Jack Ridgell 0-472
 Print Name of Pump Installer and License No. (if applicable)

Jack Ridgell
 Signature of Pump Installer

RECEIVED

NOV 08 2006

BY: OLWF