State	Well Report	For Office Use Only:		
County: JUCKSON	Part 1	-		
	ent of Environmental Quality d and Water Resources	Aquifer: Well #: <b>F</b> -319		
Driller TVICT NVITTY NICH NKVI	. Box 10631			
Jackson	, MS 39289-0631 )1)961-5210	L. S. Elevation:		
(601)	354-6938 (fax)	E-log #:		
State Law requires that this report be prepared by a 30 days of completion of drilling of the well.	he driller in detail and filed wi	ith the Department within		
Well Owner Information	Well	Location		
Owner Name CHUCK RODRIGUEZ, SR.	Latitude: 30 • 28 5/4	" Longitude <u>188.57</u> .803." <b>48</b>		
Mailing Address: POlly Lake Rd.	Method of Lat/Long (circle on	e): Conventional Survey, <b>70</b>		
	USGS quad, (Hand-held	GPS, Survey-grade GPS		
Vancleave, MS 39565	NW1/ NE 1/4 Sec 23	Twn <u>T.5.5</u> Rng <u>R7</u> W		
Telephone No. (228 U23-1189	Distance Direction <u>6</u> Miles Nowith of	Nearest Town of VANCLEANC		
We	il Data			
Purpose of Well (circle one) (Home) Industrial Public Supply Irrigation Fish Culture Other:				
Date well drilling started: 1-17-07 Date well drilling completed: 1-18-07				
If flowing, method of flow regulation: Valve <u>N/A</u> Other	(describe)			
Static Water Level:feet above or felow (circle on	e) land surface Date measured:	1-18-07		
Method of Measurement (circle one) steel tape electric ta	pe air line other:			
Hole depth: $\underline{240'}$ Well depth: $\underline{240'}$				
Type of grout (circle one): Cement Bentonite M	x			
Casing length: <u>225</u> feet Casing diameter: <u>2</u>	inches Type of casing:	DVC		
Screen length:	inches Type of screen:			
Screen slot size: <u>0004</u> inches Setting depth: From <u>225</u> feet to <u>240</u> feet				
Type of completion (circle all applicable): Gravel packed Une	erreamed Telescoped Open h	nole Natural Development		
Other (describe):				
Top of lap pipe or reduction in casing:feet. If telescoped or more than one screen, describe on back of page				
Logs run (circle all applicable) No log run Electric Gamma R	y Density Sonic Neutron O	)ther:		
Name of organization running log(s): NIA				
I certify that the well was drilled, constructed, and completed i				
Department of Environmental Quality and/or the Mississippi Department of Health regulations and state laws.				
Jack Ridgdell D-472		Ratydue		
Print Name of Water Well Contractor and License No.	Signature of W	Vater Well Contractor		

۳. ۴

-


s de series En constantes

## F-319

If well telescopes please sketch below and show depths.

Ground Level	Description of Formations Encountered	From	T₀ [五]
	Top Soil Orange clay Brown charse sand Orange t Blue clay Gray med sand Blue clay Gray med sand	- 13 - 13 - 130 - 130 - 145 - 230	13 135 145 145 340

If more than one screen, show location of each on sketch

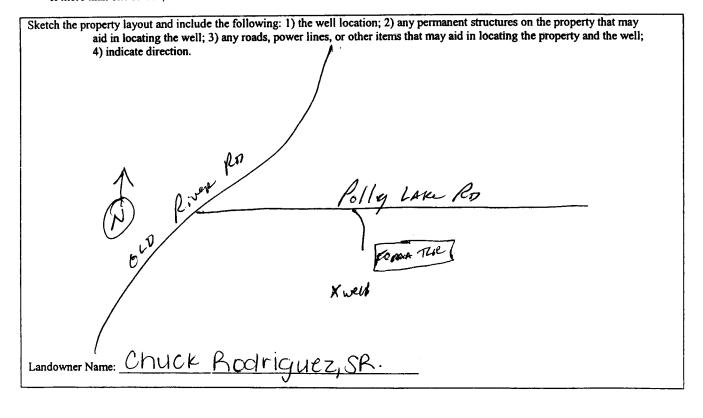

Jul Kidgdur Signature of Water Well Contractor

STATE WELL REPORT					
County: <u>JACKSON</u> Permit #: Driller <u>Cast Water Well</u> SRV. Date completed: <u>1-18-07</u>	Part 2 Pump Installer's Completion Report Mississippi Department of Environmental Quality Office of Land and Water Resources P.O. Box 10631 Jackson, MS 39289-0631 (601)961-5210 (601)354-6938 (fax)		For Office Use Only:    Aquifer:    Well #: <b>F- 3 9</b> Elevation:		
This report should be prepared by t installation of pump.	be pump installer in det	ail and filed with the Departme	nt within 30 days of the		
Well Owner Informa	tion				
Owner Name: <u>CHUCK RODRIC</u> Mailing Address: <u>POILY LAKE</u>		Latitude: <u>30 38 514</u> Longitude: <u>088 57 803</u> Method of Lat/Long (circle one): Conventional Survey, USGS quad, (Hand-held GPS,) Survey-grade GPS			
Vancleave, M City State Telephone No. 28 023 - 1189	$\frac{N \omega_{1/4} N \varepsilon_{1/4} N \varepsilon_{1/4}}{\text{Zip Code}}$		<u>3 Twn 755 Rng R74</u> Nearest Town		
	Telephone No. 208 023-1189 6 Miles NCRTH of VAN clean				
Pump Type Circle one			ver Type rcle one		
Air Lift Jet	Submersible	Diesel Engine Gasoline	e Engine Natural Gas		
Bucket Piston	Turbine	Electric Motor Hand	Tractor PTO		
Centrifugal Rotary	Flowing Well	Windmill Other (s	pecify):		
Other (specify):	Horse Power Rating of Motor: 2 HP				
Date Pump Installed:	Date Pump Installed:		TOPPIDEfeet		
Rated Pump Capacity:8	Gallons Per Minute	Number of Stages:			
Pump Test Data		Method of Mea	suring Water Level		
Date Well Tested: 1-19-07			cle one		
Static Water Level (A): Feet Below Land Surface		Air Line Electric Measu	uring Line Steel Tape		
		Other (specify):			
Pumping Water Level (B): <u>NA</u> Feet Below Land Surface					
Q		For flowing well, measured shut in head: $\underline{N/A}$ feet			
	Gallons Per Minute Well yielded GPM with a drawdown of				
Duration of Pump Test (minimum 4 hours): hours N/Afeet after hours of pumping					
I HEREBY CERTIFY that the above statements are true to the best of my knowledge. JACK Ridgdell D-472 Print Name of Pump Installer and License No. (if applicable) Signature of Pump Installer					
		Congrate of 1 whip first			

× - - - - - -

\*

.

Ha**ra** 200 En Olivar