• •	_	
	.30° 35.	530 088°41 32
State W	ell Report	For Office Use Only:
Torrson P	Part 1	
Permit #: Office of Land a	t of Environmental Quality and Water Resources	Aquifer: Well #: F - 325
	Box 10631 4S 39289-0631	L. S. Elevation:
Date drilling completed: $2 - [3 - 0]$ (601)	961-5210	
(601)35	4-6938 (fax)	E-log #:
State Law requires that this report be prepared by the 30 days of completion of drilling of the well.		
Well Owner Information		Location
Dwner Name Mark SeyMour	Latitude: 30 • 53 : 53	" Longitude 188 • 497 - 50 - 5
Mailing Address: Spring Lake Drive East	Method of Lat/Long (circle or	ne): Conventional Survey,
· V	USGS quad, Hand-held	GPS Survey-grade GPS
Vancieave, MS 39545 City State Zip Code	SF 1/2 500 1/2 Sec 21	Twn 755 Rng R7W
Felephone No. (228) 218 - 35 69	Distance Direction <u>4/2</u> Miles North	Nearest Town of VAwcleane
Well		
Purpose of Well (circle one) Home Industrial Public Supply		Other:
Date well drilling started: $2 - 12 - 07$ Date v	5	
f flowing, method of flow regulation: Valve \underline{N} \underline{A} Other (d		
Static Water Level: 80 feet above or below (circle one)		2-12-07
Method of Measurement (circle one) steel tape electric tape Hole depth:		10 5-1
	well grouted to a depth of	<u> </u>
Type of grout (circle one): Cement Bentonite Mix		
Casing length: $\underline{\underline{A}}\underline{\underline{U}}\underline{\underline{O}}$ feet Casing diameter: $\underline{\underline{A}}$		1
-	inches Type of screen:	<u>pvo</u>
Screen slot size:	<u>ACC</u> feet to	<u>2</u> / <u></u> feet
Type of completion (circle all applicable): Gravel packed Under	rreamed Telescoped Open	hole Natural Development
Other (describe):		· · · · · · · · · · · · · · · · · · ·
Top of lap pipe or reduction in casing:feet. If te	-	
Logs run (circle all applicable) No log run Electric Gamma Ray	Density Sonic Neutron	Other:
Name of organization running log(s): NA I certify that the well was drilled, constructed, and completed in a	accordance with all applicable	requirements of the Mississioni
Department of Environmental Quality and/or the Mississippi De	••	• ••
TACK Ridgdell D-472		, halden
Print Name of Water Well Contractor and License No.	Signature of	Water Well Contractor
	<i>U</i>	<u>silve</u>
		MAR 1 2
		Service & P

¢

BY: OLV	VR	;
---------	----	---


F-325

If well telescopes please sketch below and show depths.

Ground Level

	Description of Formations Encountered	From	То
	Teo Soil	0	$\left \mathbf{\lambda} \right $
	Drange clay	12	20
	Brown coarse sand	ao	80
	BILLE Clay	80	208
	Gray medium to curvisesan	208	270
	CII M TICARONI WERE WAR		
		<u>├</u> -	
		<u> </u>	
		<u> </u>	
		<u> </u>	
		┼───	<u>├ </u>
		╂────	<u> </u>
		<u> </u>	╂
		<u> </u>	
		 	
		<u> </u>	
		1	
f anah an skatah			

If more than one screen, show location of each on sketch

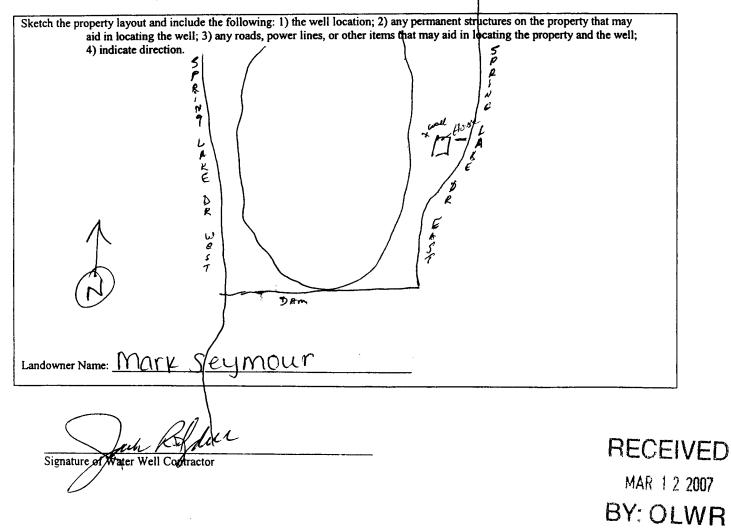

			20)),) <i>2</i> 0 32	088°41
		STATE W	ELL REPORT		
Trick	<u></u>		Part 2	For O	ffice Use Only:
County: JACK		Mississippi Departm	r's Completion Report ent of Environmental Qua	lity Aquifer.	
Permit #:	1010010		d and Water Resources D. Box 10631	J	- 225
Driller: (DUST V	Jater Wells	Jackson (60	, MS 39289-0631 01)961-5210	Well #:	- 325
Date completed:	<u>d-12-01</u>		354-6938 (fax)	Elevation:	
		by the pump installer in de	etail and filed with the De	partment within 30 d	ays of the
installation of	Well Owner Infor	mation	1	Well Location	
	Jark Sey		Latitude: 30°.35	Longitude: 0	88° 410 .5.53
Mailing Address	springlak	e Dr. East	Method of Lat/Long (circle one): Convention	nal Survey,
_	· J		USGS qua	l, Hand-held GPS, Su	rvey-grade GPS
V	ancleaver	ns 39545 te Zip Code	<u>SE 14.500 14 :</u>	Sec_21_Twn <u>755</u>	Rng R7W
	-			ction Nearest To	
felephone No. (2	28 218-35	569	<u>4/2 Miles No.</u>	est of Vowele	Hor
			<u>_</u>		J
	Pump Type Circle one	2		Power Type Circle one	
Air Lift	Jet	Submersible	Diesel Engine	Gasoline Engine	Natural Gas
Bucket	Piston	Turbine	Electric Motor	Hand	Tractor PTO
Centrifugal	Rotary	Flowing Well	Windmill	Other (specify):	
Other (specify):			Horse Power Rating of	f Motor: <u>AttP</u>	
Date Pump Installe	d: <u> </u>	1	Setting Depth: 100 F		_feet
Rated Pump Capac	ity:9	Gallons Per Minute	Number of Stages:		
	Pump Test D:		Maha]
Data Well Trated	2-14-0		WICLUG	l of Measuring Water Circle one	Level
	<u> </u>		Air Line Elect	ric Measuring Line	Steel Tape
		eet Below Land Surface	Other (specify):		
	•	eet Below Land Surface			
	· ^	eet Below Land Surface	For flowing well, meas		•
est Pumping Rate	:9	Gallons Per Minute	Well yielded	GPM with a	drawdown of
Duration of Pump	Fest (minimum 4 hou	rs): <u> </u>	_NIAfeet	after <u>N/A</u> h	ours of pumping
UEDEDV OFD	EV that the alternation	·····			
		tements are true to the best 1170	of my knowledge.	lifdur	1
	p Histaller and Licens	Se No. (if applicable)	Signature of P	ung Installer	RECEIV