	Well Report	For Office Use Only:				
County: JUCKSCN Mississinni Departm	Part 1 ent of Environmental Quality	Aquifer				
Permit #: Office of Lan	d and Water Resources	Well #: F-354				
). Box 10631 , MS 39289-0631	L. S. Elevation:				
Date drilling completed: $7 - 1807$ (60))1)961-5210					
(601)	354-6938 (fax)	E-log #:				
State Law requires that this report be prepared by the driller in detail and filed with the Department within 30 days of completion of drilling of the well.						
Well Owner Information		Location				
Owner Name_JChin Clax +01		8" Longitude 088 • 41 · 504"				
Mailing Address: Spring Lake DR. EAST	Method of Lat/Long (circle or	ne): Conventional Survey,				
	USGS quad, (Hand-held	GPS Survey-grade GPS				
Vancieave (M5 395105 City State Zip Code	<u>SF 14 500 14 Sec 21</u>	Twn <u>'75'5</u> Rng <u>R'7W</u>				
Telephone No. (208) 380-92100	Distance Direction <u>4'/2</u> Miles <u>Morerty</u>	Nearest Town of <u>/Ancleance</u>				
We	ll Data					
Purpose of Well (circle one) Home Industrial Public Supply Irrigation Fish Culture Other:						
Date well drilling started: <u>7-17-07</u> Date well drilling completed: <u>7-18-07</u>						
If flowing, method of flow regulation: Valve <u>N'</u> Other (describe)						
Static Water Level: <u>90</u> feet above or below circle one) land surface Date measured: <u>7-12-07</u>						
Method of Measurement (circle one) steel tape electric tape air line other:						
Hole depth: <u>350 FT</u> Well depth: <u>350 FT</u> Well grouted to a depth of <u>10</u> feet						
Type of grout (circle one): Cement Bentonite Mi						
Casing length: <u>235</u> feet Casing diameter: <u>2</u> inches Type of casing: <u>DNC</u>						
Screen length: 15 feet Screen diameter: 2 inches Type of screen: DVC						
Screen slot size: <u>PDS</u> inches Setting depth: From <u>335</u> feet to <u>350</u> feet						
Type of completion (circle all applicable): Gravel packed Unc	erreamed Telescoped Open	hole Natural Development				
Other (describe):						
Top of lap pipe or reduction in casing:feet. If telescoped or more than one screen, describe on back of page						
Logs run (circle all applicable) No log run Electric Gamma Ray Density Sonic Neutron Other:						
Name of organization running log(s): N/A						
I certify that the well was drilled, constructed, and completed in accordance with all applicable requirements of the Mississippi Department of Environmental Quality and/or the Mississippi Department of Health regulations and state laws.						
Joak Didedell 10 1170		and state laws.				
Print Name of Water Wall Contraction and V	auh,	rappur				
Print Name of Water Well Contractor and License No. Signature of Water Well Contractor RFCEVED						
		AUG 0 1 2007				

e * 1

BY: OLWR

1-- 354


If well telescopes please sketch below and show depths.

Ground Level

۶ I

	Description of Formations Encountered TOP SOUL Urange Clay White clay wistreaks of sand Bue clay wistreaks of sand Gray Coarse Sand	From 0 240 95 213 	

If more than one screen, show location of each on sketch

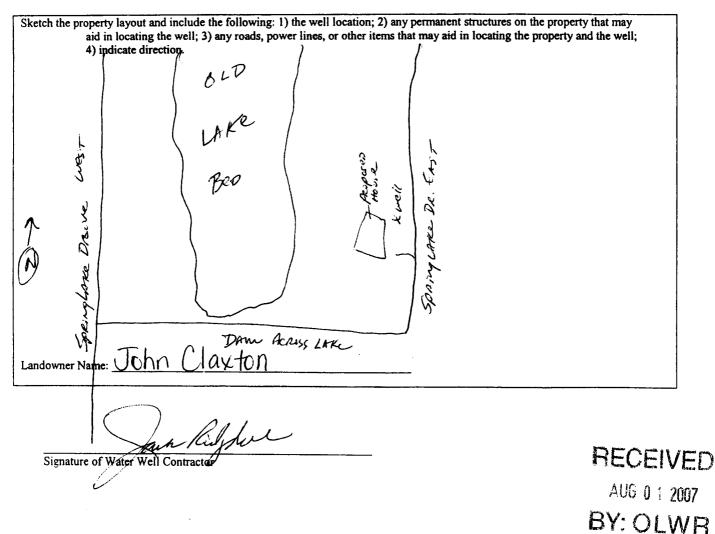

	STATE W	ELL REPORT	
County: JACKSON Permit #: Driller: COAST WATER WELLSRV. Date completed:7-18-07	Part 2 Pump Installer's Completion Report Mississippi Department of Environmental Quality Office of Land and Water Resources P.O. Box 10631 Jackson, MS 39289-0631 (601)961-5210 (601)354-6938 (fax)		For Office Use Only: Aquifer: Well #: <u>F-354</u> Elevation:
This report should be prepared by th	ne pump installer in de	tail and filed with the Departme	nt within 30 days of the
installation of pump. Well Owner Informat	ion		Location
Owner Name: John Claxton		Latitude: 3035'478"	Longitude: 088°41'504"
Mailing Address: Spring Lake	DR East	Method of Lat/Long (circle on	c): Conventional Survey,
		USGS quad, Hand	-held GPS, Survey-grade GPS
City State Zip Code		$\frac{SE}{4} \frac{SW}{4} \frac{SW}{4} \frac{Sec}{21} \frac{21}{1} \text{Twn} \frac{TSS}{TSS} \frac{Rng}{R} \frac{R}{10} \frac{21}{10}$	
Telephone No. (228) 380 -93(00		Distance Direction Nearest Town <u>4/2</u> Miles <u>Northrof</u> Vancleme	
Pump Type			ver Type
Circle one	Cuba and the		rcle one
Air Lift Jet Bucket Piston	Submersible Turbine	Diesel Engine Gasoline Electric Motor Hand	e Engine Natural Gas
Centrifugal Rotary	Flowing Well		Tractor PTO
Other (specify):	U U	Horse Power Rating of Motor:	specify):
Date Pump Installed:		Setting Depth: 120 FL OVOP PIPE_feet	
Rated Pump Capacity:	_	Number of Stages:	
Pump Test Data Date Well Tested: 7-3()-07			suring Water Level cle one
	Below Land Surface	Air Line Electric Measu	uring Line Steel Tape
Pumping Water Level (B): NIA Feet B		Other (specify):	
Drawdown [(B) – (A)]: N/A Feet E		For flowing well, measured shu	t in head: N/A feet
Test Pumping Rate: 8,5		Well yielded 8.5	
Duration of Pump Test (minimum 4 hours):	hours		hours of pumping
I HEREBY CERTIFY that the above stateme	into are true to the horizont	6	
Tack Ridgdell 0-472 Print Name of Pumplinstaller and License No		signature of Pump Last	Hur RECEIVED
		Cipilature of rumpdHSt	AUG 0 2007
			and the set of the set
			BY: OLWR

• • •