

# State Well Report

## Part 1

Mississippi Department of Environmental Quality  
Office of Land and Water Resources  
P.O. Box 10631  
Jackson, MS 39289-0631  
(601)961-5210  
(601)354-6938 (fax)

For Office Use Only:

Aquifer: \_\_\_\_\_  
Well #: F-364  
L. S. Elevation: \_\_\_\_\_  
E-log #: \_\_\_\_\_

County: JACKSON  
Permit #: \_\_\_\_\_  
Driller: Coast Water Well SRV.  
Date drilling completed: 9-14-07

**State Law requires that this report be prepared by the driller in detail and filed with the Department within 30 days of completion of drilling of the well.**

Well Owner Information	Well Location
Owner Name: <u>Tony Craven, JR.</u>	Latitude: <u>30° 38' 00"</u> Longitude: <u>088° 41' 24"</u>
Mailing Address: <u>201035 Busby Rd.</u>	Method of Lat/Long (circle one): Conventional Survey, <u>19</u>
<u>Vanderveer, MS 39565</u>	USGS quad: <u>(Hand-held GPS)</u> Survey-grade GPS
City: _____ State: _____ Zip Code: _____	<u>NW 1/4, R1E 1/4, S44</u> Twn <u>T5S</u> Rng <u>R7W</u>
Telephone No. <u>228 282-2763</u>	Distance: <u>7 1/2</u> Miles Direction: <u>North</u> Nearest Town: <u>Vanderveer</u>

**Well Data**

Purpose of Well (circle one) Home Industrial Public Supply Irrigation Fish Culture Other: \_\_\_\_\_

Date well drilling started: 9-14-07 Date well drilling completed: 9-14-07

If flowing, method of flow regulation: Valve N/A Other (describe) \_\_\_\_\_

Static Water Level: 100 feet above or below (circle one) land surface Date measured: 9-14-07

Method of Measurement (circle one) steel tape electric tape air line other: \_\_\_\_\_

Hole depth: 665' Well depth: 665' Well grouted to a depth of 10 feet

Type of grout (circle one): Cement Bentonite Mix

Casing length: 651 feet Casing diameter: 2 inches Type of casing: PVC

Screen length: 14 feet Screen diameter: 2 inches Type of screen: PVC

Screen slot size: .006 inches Setting depth: From 651 feet to 665 feet

Type of completion (circle all applicable): Gravel packed Underreamed Telescoped Open hole Natural Development

Other (describe): \_\_\_\_\_

Top of lap pipe or reduction in casing: \_\_\_\_\_ feet. If telescoped or more than one screen, describe on back of page

Logs run (circle all applicable) No log run Electric Gamma Ray Density Sonic Neutron Other: \_\_\_\_\_

Name of organization running log(s): N/A

I certify that the well was drilled, constructed, and completed in accordance with all applicable requirements of the Mississippi Department of Environmental Quality and/or the Mississippi Department of Health regulations and state laws.

Jack Ridgdell 0-472  
Print Name of Water Well Contractor and License No.


[Signature]  
Signature of Water Well Contractor

**RECEIVED**  
OCT 18 2007  
BY: OLWR

F-364

If well telescopes please sketch below and show depths.


Ground Level

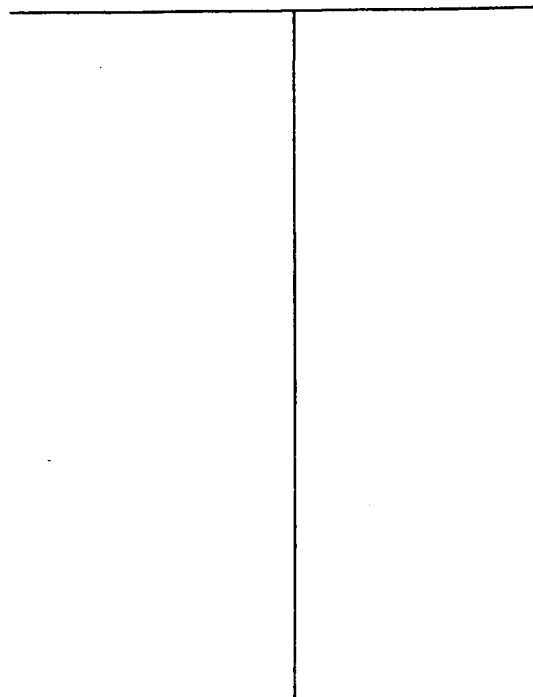


Description of Formations Encountered	From	To
Top Soil	0	3
orange clay	3	25
Blue clay	25	281
Gray low medium sand	281	292
Blue clay w/ streaks of sand	292	649
Gray medium to coarse sand	649	665

If more than one screen, show location of each on sketch

Sketch the property layout and include the following: 1) the well location; 2) any permanent structures on the property that may aid in locating the well; 3) any roads, power lines, or other items that may aid in locating the property and the well; 4) indicate direction.

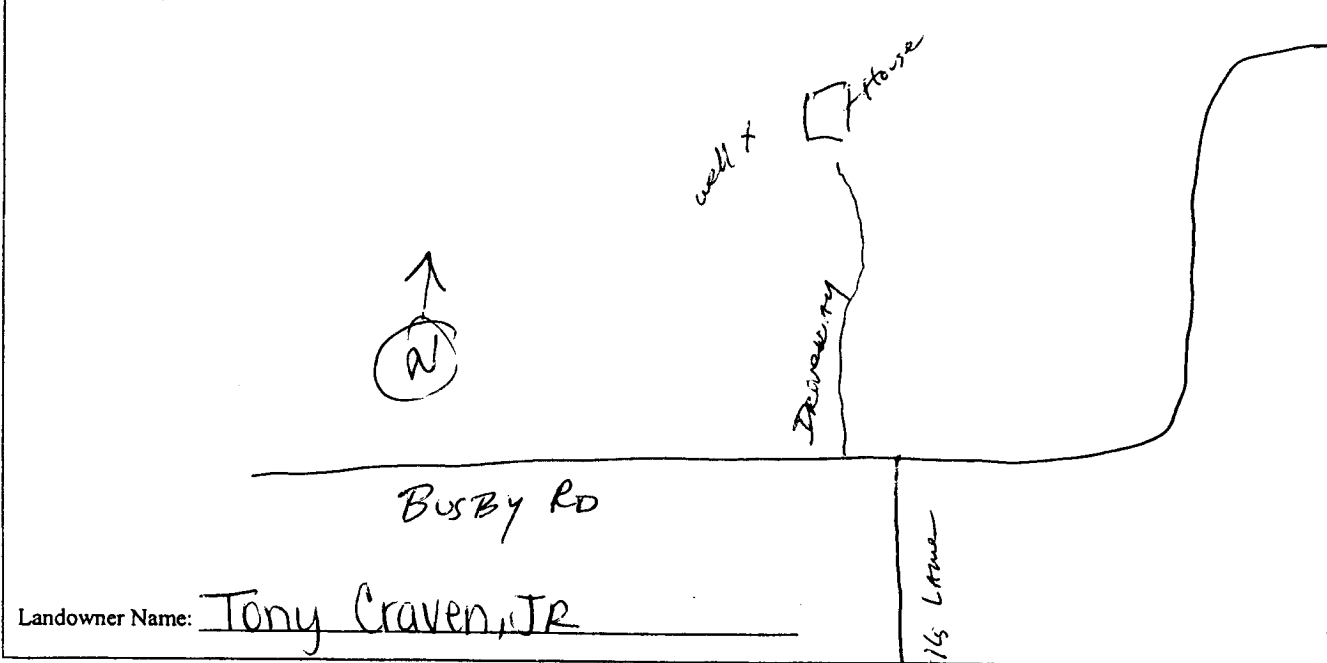

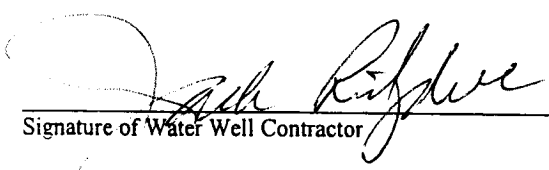  
Signature of Water Well Contractor

RECEIVED  
OCT 16 2007  
BY: OLWR

# STATE WELL REPORT

## Part 2

**Pump Installer's Completion Report**  
 Mississippi Department of Environmental Quality  
 Office of Land and Water Resources  
 P.O. Box 10631  
 Jackson, MS 39289-0631  
 (601)961-5210  
 (601)354-6938 (fax)

For Office Use Only:

Aquifer: \_\_\_\_\_

Well #: F-364

Elevation: \_\_\_\_\_

County: JACKSON

Permit #: \_\_\_\_\_

Driller: Coast Water Well Serv.

Date completed: 9-14-07

**This report should be prepared by the pump installer in detail and filed with the Department within 30 days of the installation of pump.**

Well Owner Information	Well Location
Owner Name: <u>Tony Craven, JR.</u>	Latitude: <u>30°38'00"</u> Longitude: <u>088°41'240"</u>
Mailing Address: <u>20035 Busby Rd.</u>	Method of Lat/Long (circle one): Conventional Survey,
<u>Vanderveer, MS 39505</u>	USGS quad, <u>Hand-held GPS</u> , Survey-grade GPS
City                      State                      Zip Code	<u>NW 1/4 Ne 1/4 Sec 14 Twn 75S Rng R 7W</u>
Telephone No. <u>228-282-2703</u>	Distance                      Direction                      Nearest Town
	<u>7 1/2</u> Miles <u>North of</u> <u>Vanderveer</u>

Pump Type Circle one	Power Type Circle one
Air Lift <u>Jet</u> Submersible	Diesel Engine                      Gasoline Engine                      Natural Gas
Bucket                      Piston                      Turbine	<u>Electric Motor</u> Hand                      Tractor PTO
Centrifugal                      Rotary                      Flowing Well	Windmill                      Other (specify): _____
Other (specify): _____	Horse Power Rating of Motor: <u>2 HP</u>
Date Pump Installed: _____	Setting Depth: <u>120 Ft. drop pipe</u> feet
Rated Pump Capacity: <u>8.5</u> Gallons Per Minute	Number of Stages: <u>8.5</u>

Pump Test Data	Method of Measuring Water Level Circle one
Date Well Tested: <u>9-17-07</u>	<u>Air Line</u> Electric Measuring Line                      Steel Tape
Static Water Level (A): <u>100</u> Feet Below Land Surface	Other (specify): _____
Pumping Water Level (B): <u>N/A</u> Feet Below Land Surface	For flowing well, measured shut in head: <u>N/A</u> feet
Drawdown [(B) - (A)]: <u>N/A</u> Feet Below Land Surface	Well yielded <u>8.5</u> GPM with a drawdown of
Test Pumping Rate: <u>8.5</u> Gallons Per Minute	<u>N/A</u> feet after <u>N/A</u> hours of pumping
Duration of Pump Test (minimum 4 hours): <u>5.25</u> hours	

I HEREBY CERTIFY that the above statements are true to the best of my knowledge.

Jack Bidgdell 0-472                      [Signature]  
 Print Name of Pump Installer and License No. (if applicable)                      Signature of Pump Installer

**RECEIVED**  
 BY: OLWR