State	Well Report				
	Part 1	For Office Use Only:			
County: JACKSUN Mississinni Depart	ment of Environmental Quality	Aquifer:			
Permit #: Office of La	nd and Water Resources	Well #: F-368			
	O. Box 10631	Well #:			
Jackso	n, MS 39289-0631	L. S. Elevation:			
	01)961-5210)354-6938 (fax)	E-log #:			
(801	JJJ-0938 (1ax)	L-10g #.			
State Law requires that this report be prepared by 30 days of completion of drilling of the well.	the driller in detail and filed w	vith the Department within			
Well Owner Information	Wel	I Location			
Owner Name_Beverly Schloss	Latitude: <u>30 • 38 57</u>	" Longitude <u>088 40 · 199</u> "			
Mailing Address 20709 Fairley Loop	Method of Lat/Long (circle or	ne): Conventional Survey,			
	USGS quad, Hand-held	GPS, Survey-grade GPS			
Nancleave, MS 39505 City State Zip Code	<u>JW 1/2 NE 1/2 Sec 3</u>				
Telephone No. (228) 8210 - 4924	Distance Direction <u>1/2</u> Miles <u>No Brot</u>	Nearest Town of			
W	cell Data				
Purpose of Well (circle one) Industrial Public Supp	y Irrigation Fish Culture	Other:			
Date well drilling started: $10 - 4 - 07$ Date well drilling completed: $10 - 5 - 07$					
If flowing, method of flow regulation: Valve \underline{NA} Other	er (describe)				
Static Water Level: <u>03</u> feet above or lelow circle or	ne) land surface Date measured:	10-5-07			
Method of Measurement (circle one) steel tape electric t	ape air line other:				
Hole depth: <u>83</u> Well depth: <u>83</u>	Well grouted to a depth of	_/ <u>()</u> feet			
Type of grout (circle one): Cement Bentonite N	fix				
Casing length: <u>73</u> feet Casing diameter: <u>2</u>	inches Type of casing:	PNC			
Screen length:feet Screen diameter:	inches Type of screen:	pvc			
Screen slot size:	m_ <u>73feet_to</u>	<u>83</u> feet			
Type of completion (circle all applicable): Gravel packed Un	nderreamed Telescoped Open	hole Natural Development			
Other (describe):					
Top of lap pipe or reduction in casing:feet. I	f telescoped or more than one scr	een, describe on back of page			
Logs run (circle all applicable) No log run Electric Gamma	Ray Density Sonic Neutron	Other:			
Name of organization running log(s): N/A					
I certify that the well was drilled, constructed, and completed Department of Environmental Quality and/or the Mississippi					
	ביקאונוויבער טו הכאונם רכצעואלוסמי				
Jack Ridgdell 0-472		UNCLOBEREIVE			
Print Name of Water Well Contractor and License No.	Signature of	Water Well Contractor			
	L.C.	BY: OLWF			

Ţ,

۴

.

÷

F- 368


If well telescopes please sketch below and show depths.

Ground Level

•

Description of Formations Encountered	From	То
 Top soil Orange clay Orange course sand Orange clay Orange clay	0 10 35	70 10 8 30 8 30 8 30 8 30 8 30 8 30 8 30
White coarse sand	48 55	55 83
······································		

If more than one screen, show location of each on sketch

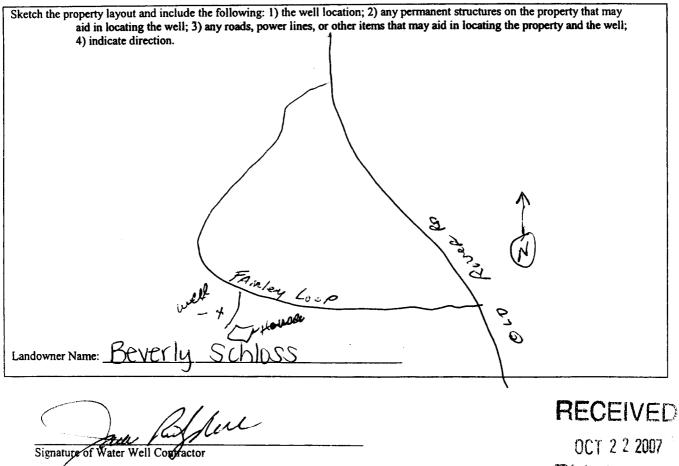

BY: OLWR

STATE WELL REPORT					
County: JACK Permit #: Driller: COAST V Date completed:	Vater Weilszv.	Pump Installer Mississippi Departme Office of Land P.O. Jackson, (601	Part 2 's Completion Report nt of Environmental Quality and Water Resources Box 10631 MS 39289-0631)961-5210 54-6938 (fax)	For Office Use Only: Aquifer: Well #:	
		the pump installer in det	ail and filed with the Departme	ent within 30 days of the	
installation of pump. Well Owner Information			Well Location		
Owner Name: BEVERIY SCHLOSS		Latitude: <u>30° 38'577'</u> 'Longitude: <u>()88°40'199</u> "			
Mailing Address: 20709 Fairley LOOP			Method of Lat/Long (circle onc): Conventional Survey,		
-			USGS quad, Hand	I-held GPS) Survey-grade GPS	
	J <u>anckave, m</u> čity 58 <u>8310 - 49</u> 6		$\frac{5\omega}{2} \frac{\sqrt{8}}{\sqrt{8}} \sqrt{8$		
l,					
	Pump Type Circle one		Power Type Circle one		
Air Lift	Jet	Submersible	Diesel Engine Gasolir	ne Engine Natural Gas	
Bucket	Piston	Turbine	Electric Motor Hand	Tractor PTO	
Centrifugal	Rotary	Flowing Well	Windmill Other	(specify):	
Other (specify):			Horse Power Rating of Motor	: <u> HP</u>	
Date Pump Installed:		Setting Depth: 73 Ft. Crop ppe_feet			
Rated Pump Capac	city: 6.5	Number of Stages:			
······	Dame Test Data				
	Pump Test Data			asuring Water Level ircle one	
Date Well Tested:		Air Line Electric Mea	suring Line Steel Tape		
	(A): <u>03</u> Fee		Other (specify):		
			For flowing well, measured sh	ut in head: <u>NIA</u> feet	
Test Pumping Rate	Test Pumping Rate: Go 5 Gallons Per Minute Well yielded GPM with a drawdown of				
Duration of Pump	Test (minimum 4 hours)	: <u>512</u> hours		VIAhours of pumping	
			· · · · · · · · · · · · · · · · · · ·	RECEIVER	
		nents are true to the best o	f my knowledge.		
UChn t	IKINS U-T ap Installer and License I	116P	Hand Hone	OCT 2 2 20\$7	
TIUN INAME OF PUM	ip distance and License I	vo. (11 applicable)	Signature of Pump In:	Staller BY: OLWP	
			/		

•

·

.