State V	ell Report	For Office Use Only:				
	Part 1	Aquifer:				
Mississippi Departme	Mississippi Department of Environmental Quality Office of Land and Water Resources					
	Box 10631	well #: F- 379				
Jackson, I	AS 39289-0631	L. S. Elevation:				
Date drining completion)961-5210 14-6938 (fax)	E-log #:				
State Law requires that this report be prepared by the 30 days of completion of drilling of the well.	e driller in detail and filed w	ith the Department within				
Well Owner Information		Location				
Owner Name JEREMY Miller	1 77	atitude: <u>30°35'332</u> " Longitude: <u>08°39', 515</u> , 34				
Mailing Address:	Method of Lat/Long (circle on	e): Conventional Survey,				
Hillcrest Estates	USGS quad, Hand-held	ld GPS Survey-grade GPS				
Vancleave MS 37565 City State Zip Code	NW 1/4 NW 1/4 Sec 26	$_{\rm Twn} T \overline{55} Rng R 7 \omega$				
Telephone No. <u>288</u> 217-0070	Distance Direction Nearest Town Miles of Vancleane					
Well	L Data					
Purpose of Well (circle one Home Industrial Public Supply Irrigation Fish Culture Other:						
Date well drilling started: $2-5-08$ Date well drilling completed: $2-5-08$						
If flowing, method of flow regulation: Valve $N A$ Other (describe)						
Static Water Level: 100feet above on below (circle one)						
\bigcirc						
Method of Measurement (circle one) steel tape electric tape air line other: Hole depth: $\ \ \ \ \ \ \ \ \ \ \ \ \ \ \ \ \ \ \ $						
Type of grout (circle one): Cement Bentonite Mix						
Casing length: <u>245</u> feet Casing diameter: <u>_</u>						
Screen length: 15 feet Screen diameter: 2 inches Type of screen: PVC OLULA						
Screen slot size: <u>1008</u> inches Setting depth: From <u>345</u> feet to <u>360</u> feet						
Type of completion (circle all applicable): Gravel packed Underreamed Telescoped Open hole Natural Development						
Other (describe):						
Top of lap pipe or reduction in casing: <u>NA</u> feet. If telescoped or more than one screen, describe on back of page						
Logs run (circle all applicable): No log run Electric Gamma Ray Density Sonic Neutron Other:						
Name of organization running log(s): NA I certify that the well was drilled, constructed, and completed in accordance with all applicable requirements of the Mississippi						
Department of Environmental Quality and/or the Mississippi Department of Health regulations and state laws.						
Jack Kidgdell 0-472- Junk Kiegden						
Print Name of Water Well Contractor and License No.	Signature of	Water Well Contractor				


F- 379

If well telescopes please sketch below and show depths.

Ground Level

	Description of Formations Encountered	From	То
	Drange Clay	$\top 0$	10
	nrange Coarse Sand	110	38
	White Clay	78	49
	BlueClay Wistreaks Of Sand	49	1774
	Gray Coarse Sand	1735	20
	programscologia	1 mar	
		+	
		+	+-+
	······································	+	
		+	
		+	
		- 	
		<u> </u>	
		1	
		1	
			[]
		+	t1
		+	<u>+</u>
		+	<u> </u>
1			<u>├</u>
	L <u></u>	<u> </u>	

If more than one screen, show location of each on sketch

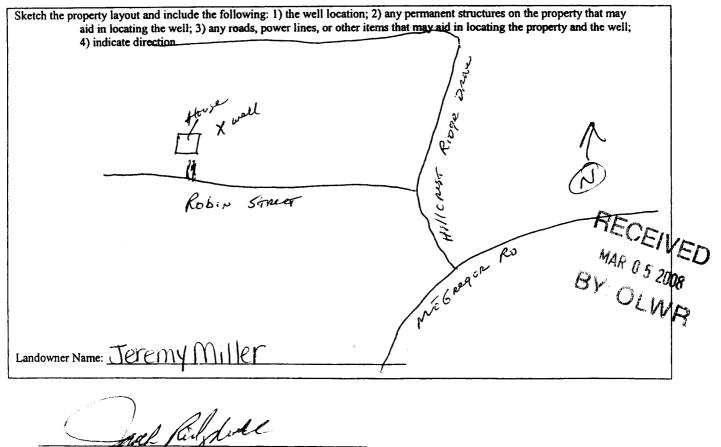

Signature of Water Well Contractor

STATE WELL REPORT						
County: Jack Permit #: Driller: ADSH Date completed:	Water Wellse	Part 2 Pump Installer's Completion Report Mississippi Department of Environmental Quality Office of Land and Water Resources		For Office Use Only: Aquifer: Well #: <u>F - 379</u> Elevation:		
This report should be prepared by the pump installer in detail and filed with the Department within 30 days of the installation of pump.						
	Well Owner Informa	tion	Well Location			
Owner Name: Je	Owner Name: Jeremy Miller		Latitude: <u>30°35′39</u> Longitude: <u>088°39′59</u> 5″			
Mailing Address:	Mailing Address: Ma		Method of Lat/Long (circle one): Conventional Survey,			
	HillcrestEstates		USGS quad, Hand	USGS quad, Hand-held GPS Survey-grade GPS		
Vancleave MS 37565 City State Zip Code		NW 1/4 NUS 1/4 Sec 26 Twn 755 Rng R 7W				
	City State	Zip Code	Distance Direction	Nearest Town		
Telephone No.	<u> 88217-00</u>	70	$-4 \text{Miles} \underline{\mathcal{N}} \in \text{or}$	E_VANCLOAVE		
· · · · · · · · · · · · · · · · · · ·		······································	· · · · · · · · · · · · · · · · · · ·			
Pump Type Circle one		Power Type Circle one				
Air Lift	Jet	Submersible	Diesel Engine Gasolin	e Engine Natural Gas		
Bucket	Piston	Turbine	Electric Motor Hand	Tractor PTO		
Centrifugal	Rotary	Flowing Well	Windmill Other (specify):		
Other (specify):			Horse Power Rating of Motor: 2 HF			
Date Pump Installed: <u>2-6-08</u>			Setting Depth: DEFTDIOPPIPE			
Rated Pump Capacity: <u>8.5</u> Gallons Per Minute			Number of Stages: <u>3</u> MAP 05 2000			
Pump Test Data			Method of Met	suring Water Friday 1 a		
Date Well Tested: 3-6-68		Ci	ssuring Water Level WA			
Static Water Level (A): CC Feet Below Land Surface		Air Line Electric Meas	uring Line Steel Tape			
Pumping Water Level (B): N A Feet Below Land Surface		Other (specify):				
			For flowing well, measured shu	ut in head: N/A feet		
0/			Well yielded <u>/ 2</u> GPM with a drawdown of			
Duration of Pump Test (minimum 4 hours):hours				N/A hours of pumping		
		· · · · · · · · · · · · · · · · · · ·				
TOWN FIVINS 0-711-P						

JChin EIKINS U-116F Print Name of Pump Installer and License No. (if applicable)

•

.

•

-

Signature of Pump Installer