	State V	Vell Report	
County: Jackson		Part 1	For Office Use Only:
		nt of Environmental Quality	Aquifer: $F430$
Permit #:		and Water Resources Box 10631	Well #:
Driller Coast Water UEIISRV.		MS 39289-0631	L. S. Elevation:
Date drilling completed: 8/25/10) 961-5210	E-log #:
	_	54-6938 (fax)	
State Law requires that this rep 30 days of completion of drilling		e driller in detail and filed w	ith the Department within
Well Owner Informa		Weil	Location
Owner Name GMTE ENterprises		Latitude: 30.34 , 4.44" Longitude: 08 . 43 . 11.34	
Mailing Address: HWY 57		Method of Lat/Long (circle one): Conventional Survey,	
¥		USGS quad, Hand-held	GPS Survey-grade GPS
Vancleave, MS 39565 City State Zip Code		SW 1/ NG 1/4 Sec 31 Twn 755 Rng R7W	
Telephone No. 008806-1703		Distance Direction	Nearest Town
	Well	Data	
			Other: CONSTRUCTION OFFI
Purpose of Well (circle one) Home Ind		-	
Date well drilling started: 8 24	Date Date	well drilling completed:	25/10
If flowing, method of flow regulation: Va	Ive N/A Other (describe)	
Static Water Level: 100feet ab	$\overline{\mathbf{C}}$		
Static water Level:ieer ad	\bigcirc		8/35/10
	teel tape electric tape		· · · · · · · · · · · · · · · · · · ·
Hole depth: <u>300 FT.</u> Well dep	\sim	Well grouted to a depth of	10feet
Type of grout (circle one): Cement	Bentonite Mix		2 .
Casing length: 280 feet Casir	ng diameter:	inches Type of casing:	NO
Screen length: <u>20</u> feet Scre	en diameter:	inches Type of screen:	PVC
Screen slot size:OOcinches	Setting depth: From _	<u>280</u> feet to <u>3</u>	<u>feet</u>
Type of completion (circle all applicable):	Gravel packed Under	rreamed Telescoped Open	nole Natural Development
	Other (describe):		
Top of lap pipe or reduction in casing:		lescoped or more than one scree	
	N/Afeet. If te	lescoped or more than one scree	en, describe on back of page
Logs run (circle all applicable No log run Name of organization running log(s):	N/Afeet. If te DElectric Gamma Ray	elescoped or more than one scree Density Sonic Neutron (en, describe on back of page Other:
Logs run (circle all applicable). No log run Name of organization running log(s): I certify that the well was drilled, constru	N/A feet. If te DElectric Gamma Ray N/A ucted, and completed in	descoped or more than one scree Density Sonic Neutron (accordance with all applicable i	en, describe on back of page Other: requirements of the Mississipp
Top of lap pipe or reduction in casing: Logs run (circle all applicable. No log run Name of organization running log(s): I certify that the well was drilled, constru Department of Environmental Quality a	N/A feet. If te DElectric Gamma Ray N/A ucted, and completed in	descoped or more than one scree Density Sonic Neutron (accordance with all applicable i	en, describe on back of page Other: requirements of the Mississipp
Logs run (circle all applicable). No log run Name of organization running log(s): I certify that the well was drilled, constru-	N/A feet. If te DElectric Gamma Ray N/A ucted, and completed in	descoped or more than one scree Density Sonic Neutron (accordance with all applicable i	en, describe on back of page Other: requirements of the Mississipp


F430

If well telescopes please sketch below and show depths.

Ground Level

el	Description of Formations Encountered	From	To
	Orange Clay		60
	Brown coatsesand	$\underline{\partial o}$	34
	branze and white clay	34	90
	Brown Coarse Sand	90	140
	Bluechay	140	264
	GraymediumSand	264	300
			<u> </u>
			┢────
		<u> </u>	
			<u> </u>
			ļ
1			ļ
			<u> </u>
			<u> </u>
		l	1

If more than one screen, show location of each on sketch

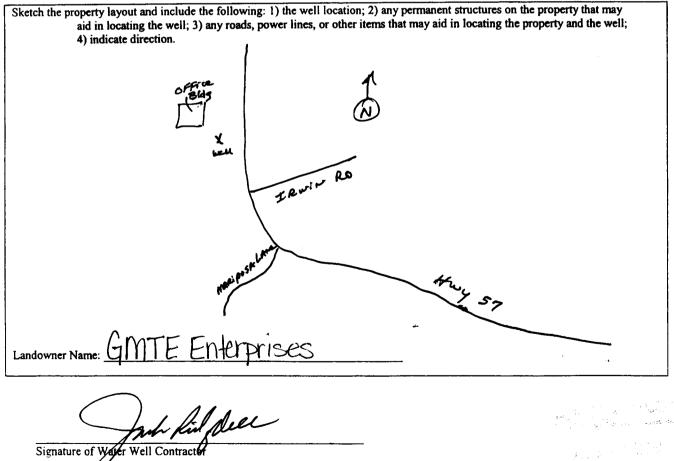



	STATE W	ELL REPORT		
County: Jackson Permit #: Driller Cast Water Well SRV. Date completed: 8/25/10	Part 2 Pump Installer's Completion Report Mississippi Department of Environmental Quality Office of Land and Water Resources P.O. Box 10631 Jackson, MS 39289-0631 (601) 961-5210 (601) 354-6938 (fax)		For Office Use Only: Aquifer: F 4 3 J Well #:	
This report should be prepared by th			ent within 30 days of the	
Inits report should be prepared by the puttip instants in deterministalization Well Owner Information Owner Name GMTE Enterprises Mailing Address:		Well Location Latitude: <u>30°34′4.44</u> Longitude <u>088°43′11.34</u> ′′ Method of Lat/Long (circle one): Conventional Survey,		
Vancleave, M City State Telephone No. 2018, 806 - 1703	_			
Pump Type Circle one			wer Type ircle one	
Air Lift Jet 🤇	Submersible	Diesel Engine Gasolin	e Engine Natural Gas	
Bucket Piston	Turbine	Electric Motor Hand	Tractor PTO	
Centrifugal Rotary Other (specify): Date Pump Installed:	Flowing Well Gallons Per Minute		1 '	
Pump Test Data			asuring Water Level rcle one	
Date Well Tested: <u>8 26 0</u> Static Water Level (A): <u>100</u> Feet I Pumping Water Level (B): <u>NA</u> Feet B	Below Land Surface	Air Line Electric Meas Other (specify):	suring Line Steel Tape	
Drawdown [(B) - (A)]: Feet E	Below Land Surface	For flowing well, measured sh	ut in head: N/A feet	
Yest Pumping Rate: 12. Ouration of Pump Test (minimum 4 hours):	Gallons Per Minute	Well yielded 	1	
HEREBY CERTIFY that the above stateme Jock Ridgdell 0-472 rint Name of Pump Installer and License No	2	of my knowledge		
		Constant of a market million		

· · · ·