	State W	ell Report						
County: Jackson	Р	art 1	For Office Use Only:					
Permit #:	Mississippi Departmen	t of Environmental Quality nd Water Resources	Aquifer: <u>+ 431</u>					
and anostulaterubilsev	Office of Land and Water Resources P.O. Box 10631		Well #:					
Drille Chast Water Water	· · · · · · · · · · · · · · · · · · ·	IS 39289-0631	L. S. Elevation:					
Date drilling completed: 9-16-10_		961-5210 4-6938 (fax)	E-log #:					
State Law requires that this rep	- ort be prepared by the	driller in detail and filed w	vith the Department within					
30 days of completion of drilling	g of the well.		Location					
Well Owner Inform Owner Name LAMAY NICHOLS			2, Longitude 088 42, 18.06					
Mailing Address: 663 Junif	\ • .	Method of Lat/Long (circle or						
	GPS, Survey-grade GPS							
			Twn <u>755</u> Rng & 7 w					
Telephone No. 228 826-50	•	Distance Direction <u>4</u> Miles North	Nearest Town of VAntcleme					
	Weil Data							
Purpose of Well (circle one Home Industrial Public Supply Irrigation Fish Culture Other:								
Date well drilling started: Date well drilling completed:								
If flowing, method of flow regulation: Va			•					
	\bigcirc	and surface Date measured:						
	teel tape electric tape	(air line) other:	10					
	pth: <u>285 FT.</u> Bentonite Mix	Well grouted to a depth of	<u> </u>					
0-0	\smile	inches Type of casing:	PVC,					
Screen length:								
Type of completion (circle all applicable)	Type of completion (circle all applicable): Gravel packed Underreamed Telescoped Open hole Natural Development							
Other (describe):								
Top of lap pipe or reduction in casing: _	N/Afeet. If tel	escoped or more than one scre	een, describe on back of page					
Logs run (circle all applicable) No log ru	Electric Gamma Ray	Density Sonic Neutron	Other:					
Name of organization running log(s): I certify that the well was drilled, const	N/A	perordance with all applicable	requirements of the Mississinni					
Department of Environmental Quality	-							
Jack Ridadell D-4	172	- Se al.	, findell					
Print Name of Water Well Contractor and	License No.	Signature of	Water Well Contractor					
L		<i>V</i>						
			S. 2. 2. 203					

• я

If well telescopes please sketch below and show depths.

F431

SEP 2 2 2010

BY:OMB


Ground Level

.,

	Description of Formations Encountered	From	То
	TOPSOIL	0	a
7	Ordnae Clay	2	91
Ĩ	Trange Charles Sand	121	38.1
	Drappe Clay	38	94
ľ	Drange misel Sand w/ Heabravel	94	B 2
	Bueclay	123	242
E	ray Coarlse Sand	242	a 85
[
[
		L	
		L	
		L	
		L	

If more than one screen, show location of each on sketch

Signature of Water Well Contractor

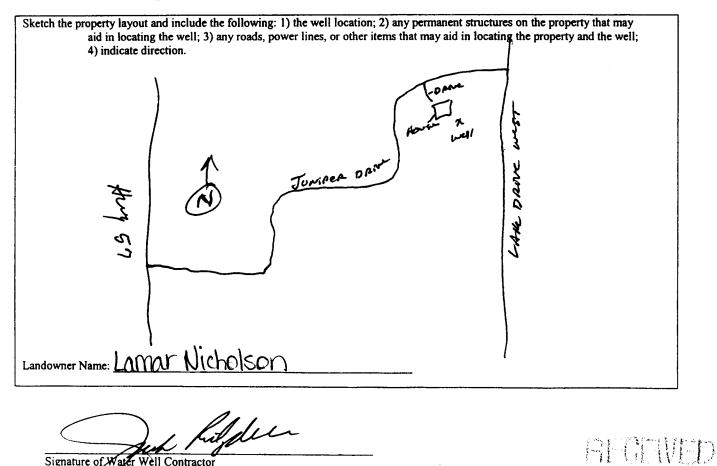

		STATE W	ELL REPORT		
County: Jac	ikson	Pump Installer	Part 2 's Completion Report ent of Environmental Quality	For Office Use Only:	
Permit #:	WaterWellsev	Office of Land	and Water Resources	Aquifer: F431	
DrillerLOast	Water Wellsev	P.O. Jackson	Box 10631 MS 39289-0631	Well #:	
Date completed:	9-16-10	(60	1) 961-5210	Elevation:	
Date completed.		(601)	354-6938 (fax)		
This report installation	of pump.			rtment within 30 days of the	
Well Owner Information			Well Location		
Owner Name: Lamar Nichokon				2 ¹ Longitude: 088° 42′ 18,06	
Mailing Address: 6162 Juniper Drive			Method of Lat/Long (circle one): Conventional Survey,		
				Hand-held GPS, Survey-grade GPS	
Vancleave MS 39565 City State Zip Code			NW 14 5F 14 Sec 29 Twn 75 5 Rng R7W		
				on Nearest Town	
Telephone No. 6	08/826-50	219	Miles No regul	of VAncleave	
	Pump Type	······································		Power Type	
	Circle one			Circle one	
Air Lift	Jet	Submersible	Diesel Engine Gas	soline Engine Natural Gas	
Bucket	Piston	Turbine		nd Tractor PTO	
Centrifugal	Rotary	Flowing Well		her (specify):	
	A 17 10			otor: <u>2 HP</u>	
	led: <u>9-17-10</u>		Setting Depth: DOFT.		
Rated Pump Capa	icity:	_Gallons Per Minute	Number of Stages:	3	
	Pump Test Data		Method of	Measuring Water Level	
Date Well Tested:	9-17-10			Circle one	
Static Water Leve	I (A): 105 Fee	t Below Land Surface	Air Line Electric M	Measuring Line Steel Tape	
Pumping Water L		Below Land Surface	Other (specify):		
Drawdown [(B) -	(A)]: <u>NA</u> Fee	Below Land Surface	For flowing well, measured	d shut in head: <u>NA</u> feet	
Test Pumping Rate:Gallons Per Minute			Well yielded 20	GPM with a drawdown of	
Duration of Pump	Test (minimum 4 hours)	:hours	NA feet afte	r <u>NA</u> hours of pumping	
I HEREBY CERT	IFY that the above stater	nents are true to the best o 472	f my knowledge.	Riffer	
Print Name of Pun	np Installer and License I	No. (if applicable)	Signature of Pump	o Installer	

•

.

est oppos