1. •••	State Well Report	
Takon	Part 1	For Office Use Only:
County: Jackson	Mississippi Department of Environmental	
Permit #:	Office of Land and Water Resource P.O. Box 10631	Well #:
Driller OGHWAHER WEISKV.	Jackson, MS 39289-0631	L. S. Elevation:
Date drilling completed: 9/30/11	(601) 961-5210	
	(601) 354-6938 (fax)	E-log #:
State Law requires that this rep 30 days of completion of drilling	ort be prepared by the driller in detail an of the well.	d filed with the Department within
Well Owner Informa	ition	Well Location
Owner Name_ James Payne		5 702 " Longitude: 08% 42.3.48,
Mailing Address: 16600 Lake		g (circle one): Conventional Survey,
		Hand-held GPS, Survey-grade GPS
Vancleave, MI	539565 <u>NE 1/2 NE 1/2 S</u>	Sec 29 V Twn TSS Rng 70
Vanc Eave, M City Sta Telephone No. 208) 526-4352	Distance D <u><u><u><u></u></u><u><u><u><u></u></u><u></u><u><u><u></u></u><u></u><u><u></u></u><u></u><u><u></u><u></u><u></u><u></u><u></u></u></u></u></u></u></u>	irection Nearest Town NOVATH of VAN Clease
	Well Data	
Purpose of Well (circle one Home) Ind	ustrial Public Supply Irrigation Fish C	Culture Other:
Date well drilling started:930		1 9/30/11
If flowing, method of flow regulation: Va	ive <u>NA</u> Other (describe)	
Static Water Level:feet al	pove or below (circle one) land surface Date n	neasured: <u>7/30///</u>
		ner:
Hole depth: <u>205 FT</u> . Well de		lepth offeet
Type of grout (circle one): Cement Casing length: feet Casing length: feet	Bentonite Mix ng diameter: A inches Type of	casing:
	en diameter: , inches Type of	OUC
Screen slot size: <u>, CO4</u> inches	Setting depth: Fromfeet	
Type of completion (circle all applicable):	Gravel packed Underreamed Telescope	d Open hole Natural Development
	Other (describe):	
Top of lap pipe or reduction in casing:	feet. If telescoped or more that	n one screen, describe on back of page
	n [/] Electric Gamma Ray Density Sonic N	leutron Other:
Name of organization running log(s):	<i>IV</i> //+ ucted, and completed in accordance with all a	unlicable requirements of the Mississinni
	ind/or the Mississippi Department of Health r	
Jack Ridadell	-472 (D. C.I.REFILE
Print Name of Water Well Contractor and	License No.	gnature of Water Well Contractor T 1 9 2011

.

Lewis Printing, Pascage in a fail


If well telescopes please sketch below and show depths.

Ground Level

بې

Description of Formations Encountered	From	To
rown Clay hite Clay white Clay rown Cloarse Sand Swe Clay ray Medium Sand	27 J C 5 0	90011599

If more than one screen, show location of each on sketch

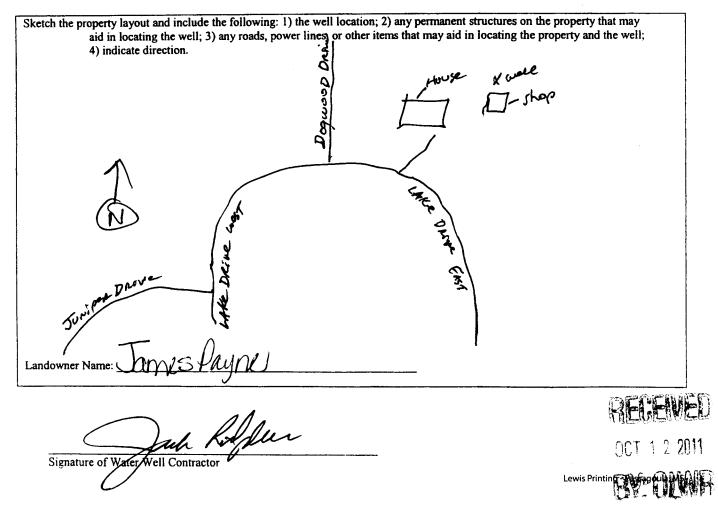

	STATE WE	LL REPORT		
County DCKSON	Part 2 Pump Installer's Completion Report Mississippi Department of Environmental Quality Office of Land and Water Resources P.O. Box 10631 Jackson, MS 39289-0631		For Office Use Only: Aquifer:	
Permit #: Driller: COAST WATCH WEI SRV			Well #:	
Date completed: 4000		961-5210 4-6938 (fax)	Elevation:	
This report should be prepared by th	e pump installer in detai	l and filed with the Departm	ent within 30 days of the	
installation of pump. Well Owner Information		Well Location		
Owner Name: JamesPayl	nl I Doing Flot	Latitude: 30 35 7.02	Longitude 88 42' 3.48	
Mailing Address: 16600 LARDKIVE EAST		Method of Lat/Long (circle one): Conventional Survey,		
			d-held GPS, Survey-grade GPS	
Vancilare, IN City State	S J J J L Zip Code	$\frac{NE_{\frac{1}{2}} NE_{\frac{1}{2}} Sec_{\frac{29}{Twn}} T5S_{Rng} R1W}{Distance}$		
Telephone No. 008 506-43	88	<u> </u>	of Voucleave	
			ower Type	
Circle one			Circle one	
Air Lift Jet	Submersible	Diesel Engine Gasoli	ne Engine Natural Gas	
Bucket Piston	Turbine	Electric Motor) Hand	Tractor PTO	
Centrifugal Rotary	Flowing Well	Windmill Other	(specify):	
Other (specify):		Horse Power Rating of Motor	SHY	
Date Pump Installed:OL_		Setting Depth: 20FT.	Drop Pipedet	
Rated Pump Capacity:9	Gallons Per Minute	Number of Stages:	3	
Pump Test Data			easuring Water Level	
	<		Circle one asuring Line Steel Tape	
Static Water Level (A):Feet	Below Land Surface	Other (specify):	·	
Pumping Water Level (B): <u>NA</u> Feet	Below Land Surface	····· (-F)/		
Drawdown [(B) – (A)]: NA Feet Below Land Surface		For flowing well, measured s	hut in head: <u>NA</u> feet	
Test Pumping Rate: 9 Gallons Per Minute		Well yielded GPM with a drawdown of		
Duration of Pump Test (minimum 4 hours):	<u> </u>	NA feet after	NA hours of pumping	
· · · · · · · · · · · · · · · · · · ·				
HEREBY CERTIFY that the above statem	tents are true to the best of \mathbf{D}	my knowledge.	Kilder RE	
Print Name of Pump Installer and License N	lo. (if applicable)	Signature of Pump In	astaller OCT 1	