

State Well Report

Part 1

Mississippi Department of Environmental Quality
Office of Land and Water Resources
P.O. Box 10631
Jackson, MS 39289-0631
(601) 961-5210
(601) 354-6938 (fax)

For Office Use Only:

Aquifer: N1079
Well #: F456
L. S. Elevation: _____
E-log #: _____

County: Jackson
Permit #: _____
Driller: Coast Water Wells Serv.
Date drilling completed: 10/29/11

State Law requires that this report be prepared by the driller in detail and filed with the Department within 30 days of completion of drilling of the well.

Well Owner Information	Well Location
Owner Name: <u>Jenea Braun</u>	Latitude: <u>30° 28' 20.94"</u> Longitude: <u>88° 45' 12.36"</u>
Mailing Address: <u>Hillcrest Ridge</u>	Method of Lat/Long (circle one): Conventional Survey, <u>35 24</u> <u>39 24</u>
<u>Vance Ave, Ms 39564</u>	USGS quad: <u>Hand-held GPS</u> Survey-grade GPS <input checked="" type="checkbox"/>
City State Zip Code	<u>SE 1/4 S 24 Sec 28 Twn T55 Rng R7W</u>
Telephone No. <u>228 860-9425</u>	Distance Direction Nearest Town
	<u>4.12</u> Miles <u>NE</u> of <u>Vance Ave</u>

Well Data

Purpose of Well (circle one) Home Industrial Public Supply Irrigation Fish Culture Other: _____

Date well drilling started: 10/27/11 Date well drilling completed: 10/28/11

If flowing, method of flow regulation: Valve N/A Other (describe) _____

Static Water Level: 125 feet above (below) (circle one) land surface Date measured: 10/28/11

Method of Measurement (circle one) steel tape electric tape air line other: _____

Hole depth: 209 FT Well depth: 209 FT. Well grouted to a depth of 10 feet

Type of grout (circle one): Cement Bentonite Mix

Casing length: 199 feet Casing diameter: 4 inches Type of casing: PVC

Screen length: 10 feet Screen diameter: 4 inches Type of screen: PVC

Screen slot size: .008 inches Setting depth: From 199 feet to 209 feet

Type of completion (circle all applicable): Gravel packed Underreamed Telescoped Open hole Natural Development

Other (describe): _____

Top of lap pipe or reduction in casing: N/A feet. If telescoped or more than one screen, describe on back of page

Logs run (circle all applicable): No log run Electric Gamma Ray Density Sonic Neutron Other: _____

Name of organization running log(s): N/A

I certify that the well was drilled, constructed, and completed in accordance with all applicable requirements of the Mississippi Department of Environmental Quality and/or the Mississippi Department of Health regulations and state laws.

Jack Ridgell 0-472

Print Name of Water Well Contractor and License No.

Jack Ridgell
Signature of Water Well Contractor


If well telescopes please sketch below and show depths.

Ground Level

Empty box for sketching well telescopes.

Description of Formations Encountered	From	To
Topsail	0	2
Orange Clay	2	18
Orange Coarse Sand	18	63
Blue Clay	63	187
Gray Medium to Coarse Sand	187	200

If more than one screen, show location of each on sketch

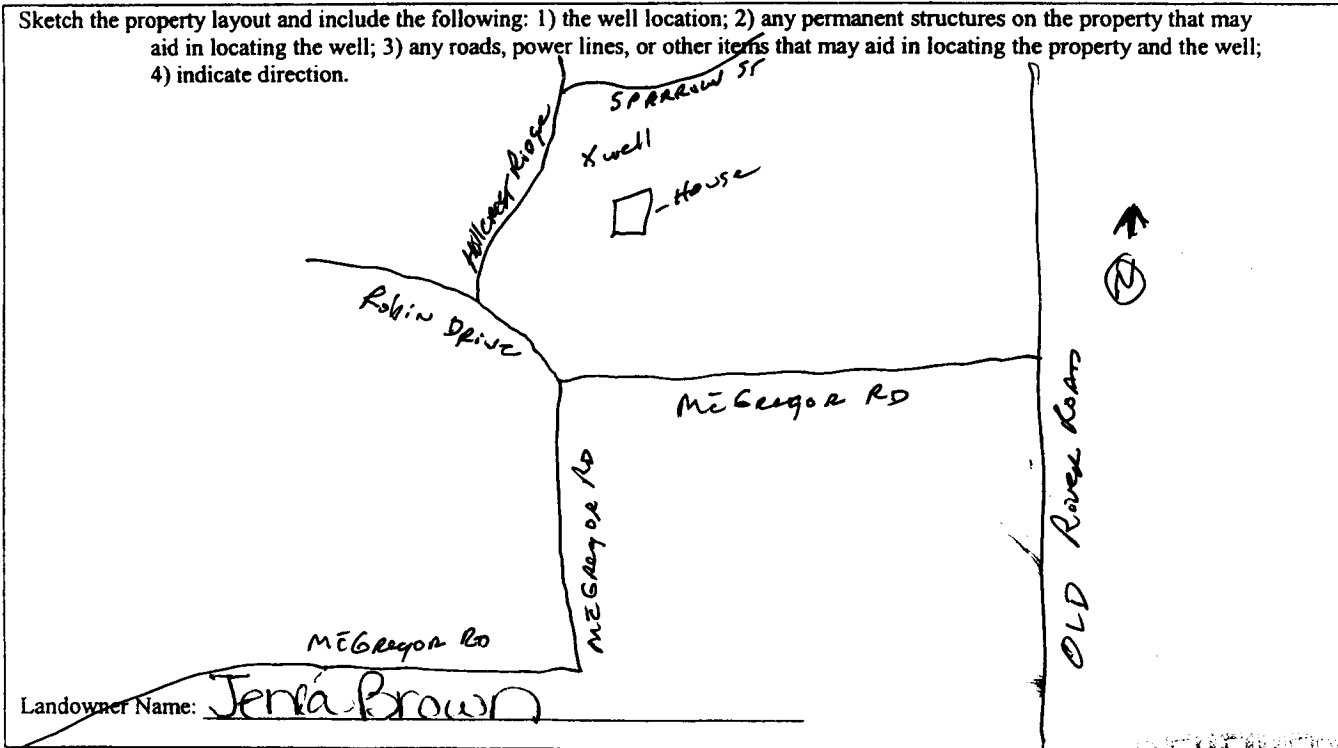

John Pilgrimage
Signature of Water Well Contractor

RECEIVED
NOV 17 2011
Lewis Printing - Pascagoula, MS

STATE WELL REPORT

Part 2

Pump Installer's Completion Report
 Mississippi Department of Environmental Quality
 Office of Land and Water Resources
 P.O. Box 10631
 Jackson, MS 39289-0631
 (601) 961-5210
 (601) 354-6938 (fax)

For Office Use Only:

Aquifer: _____

Well #: F456

Elevation: _____

County: Jackson
 Permit #: _____
 Driller: Coast Water Well Serv.
 Date completed: 10/29/11

This report should be prepared by the pump installer in detail and filed with the Department within 30 days of the installation of pump.

Well Owner Information	Well Location
Owner Name: <u>Jenea Brown</u>	Latitude: <u>30° 22' 20.94"</u> Longitude: <u>088° 45' 12.36"</u>
Mailing Address: <u>Hillcrest Ridge</u>	Method of Lat/Long (circle one): Conventional Survey, <u>35 24</u> <u>39 24</u>
<u>Vanderveer, Ms. 39565</u>	USGS quad: <u>Hand-held GPS</u> Survey-grade GPS
City State Zip Code	<u>SE 1/4 SW 1/4 Sec 28 Twn T55 Rng R7W</u>
Telephone No. <u>228 860-9125</u>	Distance Direction Nearest Town
	<u>4 1/2</u> Miles <u>NE</u> of <u>Vanderveer</u>

Pump Type Circle one	Power Type Circle one
Air Lift Jet <input type="radio"/> <u>Submersible</u> <input checked="" type="radio"/>	Diesel Engine Gasoline Engine Natural Gas
Bucket Piston Turbine <input type="radio"/>	<u>Electric Motor</u> <input checked="" type="radio"/> Hand Tractor PTO
Centrifugal Rotary Flowing Well <input type="radio"/>	Windmill Other (specify): _____
Other (specify): _____	Horse Power Rating of Motor: <u>1 H.P.</u>
Date Pump Installed: <u>10/29/11</u>	Setting Depth: <u>200 FT. DROP PIPE</u> feet
Rated Pump Capacity: <u>10</u> Gallons Per Minute	Number of Stages: <u>15</u>

Pump Test Data	Method of Measuring Water Level Circle one
Date Well Tested: <u>10/29/11</u>	<u>Air Line</u> <input checked="" type="radio"/> Electric Measuring Line Steel Tape
Static Water Level (A): <u>125</u> Feet Below Land Surface	Other (specify): _____
Pumping Water Level (B): <u>N/A</u> Feet Below Land Surface	For flowing well, measured shut in head: <u>N/A</u> feet
Drawdown [(B) - (A)]: <u>N/A</u> Feet Below Land Surface	Well yielded <u>30</u> GPM with a drawdown of
Test Pumping Rate: <u>11</u> Gallons Per Minute	<u>N/A</u> feet after <u>N/A</u> hours of pumping
Duration of Pump Test (minimum 4 hours): <u>5 1/2</u> hours	

I HEREBY CERTIFY that the above statements are true to the best of my knowledge.

Jack Ridgell 0-472
 Print Name of Pump Installer and License No. (if applicable)

Jan Ribzelle
 Signature of Pump Installer

RECEIVED

NOV 17 2011

BY: [Signature]