[]	State Well Report				
County: Jackson	Part 1	For Office Use Only:			
Missi	issippi Department of Environmental Quality	Aquifer: <u>+ 463</u>			
Permit #:	Office of Land and Water Resources	Well #:			
Driller COAST WATER URISRV.	P.O. Box 10631 Jackson, MS 39289-0631				
Date drilling completed: 5/35/12	(601) 961-5210	L. S. Elevation:			
Date drining completed. Stastie	(601) 354-6938 (fax)	E-log #:			
State Law requires that this report be prepared by the driller in detail and filed with the Department within 30 days of completion of drilling of the well.					
Well Owner Information	We	ell Location			
Owner Name_Josh Hall		<u>2</u> " Longitude: <u>088-43</u> , <u>20.10</u> "			
Mailing Address: Hwy 57	Method of Lat/Long (circle of	Method of Lat/Long (circle one): Conventional Survey,			
	USGS quad, Hand-hel	USGS quad, Hand-held GPS Survey-grade GPS			
Vancleave, MS 3	$\frac{39565}{\text{Zip Code}} \qquad N^{\text{W}} \sqrt[7]{355} \sqrt{355} \sqrt{355}$	NW 1/ SE 1/2 Sec 301 Twn ITS Rng BS W			
Telephone No. 61 508-6968		Distance Direction Nearest Town <u>4</u> Miles <u>N</u> of <u>V</u> Awdenue			
	Well Data				
Purpose of Well (circle one) Home Industrial					
Date well drilling started: $5/25/12$ Date well drilling completed: $5/25/12$					
If flowing, method of flow regulation: Valve <u>NA</u> Other (describe)					
Static Water Level:feet above of below (circle one) land surface Date measured:5/25/12.					
Method of Measurement (circle one) steel tape electric tape air line other:					
Hole depth: 140FT Well depth: 140 FT Well grouted to a depth of 10 feet					
Type of grout (circle one): Cement Bentonite Mix					
Casing length: 130 feet Casing diameter: 2 inches Type of casing: PVC					
Screen length: 0 feet Screen diameter: 0 inches Type of screen: PVC					
Screen slot size: <u>006</u> inches Setting depth: From <u>30</u> feet to <u>140</u> feet					
Type of completion (circle all applicable): Grav	el packed Underreamed Telescoped Ope	n hole Natural Development			
Other (describe):					
Top of lap pipe or reduction in casing: feet. If telescoped or more than one screen, describe on back of page					
Logs run (circle all applicable). No log run Electric Gamma Ray Density Sonic Neutron Other:					
Name of organization running log(s): N/A					
I certify that the well was drilled, constructed, and completed in accordance with all applicable requirements of the Mississippi Department of Environmental Quality and/or the Missiscippi Department of Health regulations and state laws					
Department of Environmental Quality and/or the Mississippi Department of Health regulations and state laws.					
Ack Kidgdell 0-472 RECEIVED July hisple					
Print Name of Water Well Contractor and License No. JUN 2 0 2012 Signature of Water Well Contractor					

i ,

BY: OLWR

If well telescopes please sketch below and show depths.


Ground Level

į

,

 Description of Formations Encountered TopSoil Orange Clay Orange Course, Sand	From	To 2 30
Orange Clay Orange Clay Orange Clarse Sand	110	770 140
		1

If more than one screen, show location of each on sketch

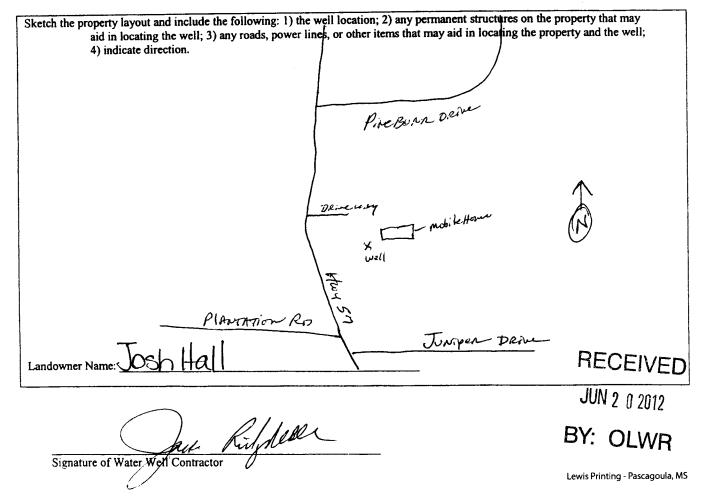

F463

STATE WELL REPORT					
County: Jackson Permit #: Driller LOOST Water WellSev. Date completed: 5/25/12	Pump Installer ³ : Mississippi Departmer Office of Land a P.O. I Jackson, M (601) 3	art 2 Completion Report it of Environmental Quality and Water Resources Box 10631 AS 39289-0631) 961-5210 54-6938 (fax)	For Office Use Only: Aquifer:		
	This report should be prepared by the pump installer in detail and filed with the Department within 30 days of the				
installation of pump. Well Owner Information Owner Name: Josh Hall Mailing Address: 16416 Hwy 57 Varcleave, Mo City State Telephone No. (601) 508-6968		Latitude: <u>30'34'51.[3"</u> Method of Lat/Long (circle on USGS quad, Hand	Held GPS Survey-grade GPS Twn <u>T75</u> Rng <u>R</u> Sω Nearest Town		
Telephone No. $([QU]) \bigcirc US - G] GS$					
Pump Type Circle one	Submersible	C	wer Type ircle one ne Engine Natural Gas		
Bucket Piston	Turbine	Electric Motor Hand	Tractor PTO		
Centrifugal Rotary	Flowing Well	Windmill Other	(specify):		
Other (specify):		Horse Power Rating of Motor	<u>I HP</u>		
Date Pump Installed: 6/-7/12		Setting Depth: 80 FT Dr	OP Pipes feet		
0	Gallons Per Minute	Number of Stages:			
Pump Test Data		Method of Me	asuring Water Level		
Date Well Tested: <u><u><u></u></u><u><u></u><u><u></u><u></u><u><u></u><u></u><u><u></u><u></u><u></u><u></u><u></u><u></u><u></u><u></u><u></u><u></u></u></u></u></u></u>	Below Land Surface Below Land Surface Below Land Surface		ircle one suring Line Steel Tape		
Test Pumping Rate:	Gallons Per Minute	Well yielded	GPM with a drawdown of		
Duration of Pump Test (minimum 4 hours):	hours	feet after	NA hours of pumping		
I HEREBY CERTIFY that the above statem <u>Jack Ridgdell</u> 0-47. Print Name of Pump Installer and License N	<u> </u>	of my knowledge. <i>Juh / U</i> <u>Signature of Pump In</u>			
			Lewis Printing - Pascagoula, MS		

: