

# State Well Report

## Part 1

Mississippi Department of Environmental Quality  
Office of Land and Water Resources  
P.O. Box 10631  
Jackson, MS 39289-0631  
(601) 961-5210  
(601) 354-6938 (fax)

For Office Use Only:

Aquifer: \_\_\_\_\_  
Well #: F472  
L. S. Elevation: \_\_\_\_\_  
E-log #: \_\_\_\_\_

County: Jackson  
Permit #: \_\_\_\_\_  
Driller: Coast Water Well Serv.  
Date drilling completed: 3/2/13

**State Law requires that this report be prepared by the driller in detail and filed with the Department within 30 days of completion of drilling of the well.**

Well Owner Information	Well Location
Owner Name: <u>John + Lisa Price</u>	Latitude: <u>30.365652</u> Longitude: <u>88.43.35.16</u>
Mailing Address: <u>Appalocosa Ridge</u>	Method of Lat/Long (circle one): Conventional Survey, _____
<u>Vardeave, MS 39565</u>	USGS quad, <u>Hand-held GPS</u> Survey-grade GPS _____
City: _____ State: _____ Zip Code: _____	<u>NW</u> 1/4 <u>NW</u> 1/4 Sec <u>18</u> ✓ Twn <u>T5S</u> Rng <u>R7W</u> ✓
Telephone No. <u>228 342-8995</u>	Distance: <u>6.14</u> Miles Direction: <u>NW</u> of Nearest Town: <u>Vardeave</u>

**Well Data**

Purpose of Well (circle one): Home Industrial Public Supply Irrigation Fish Culture Other: \_\_\_\_\_

Date well drilling started: 2/28/13 Date well drilling completed: 3/2/13

If flowing, method of flow regulation: Valve N/A Other (describe) \_\_\_\_\_

Static Water Level: 105 feet above or below (circle one) land surface Date measured: 3/2/13

Method of Measurement (circle one) steel tape electric tape air line other: \_\_\_\_\_

Hole depth: 800 FT Well depth: 2 Well grouted to a depth of PVC feet

Type of grout (circle one): Cement Bentonite Mix

Casing length: 780 feet Casing diameter: 2 inches Type of casing: PVC

Screen length: 20 feet Screen diameter: 2 inches Type of screen: PVC

Screen slot size: .006 inches Setting depth: From 780 feet to 800 feet

Type of completion (circle all applicable): Gravel packed Underreamed Telescoped Open hole Natural Development

Other (describe): \_\_\_\_\_

Top of lap pipe or reduction in casing: N/A feet. If telescoped or more than one screen, describe on back of page

Logs run (circle all applicable): No log run Electric Gamma Ray Density Sonic Neutron Other: \_\_\_\_\_

Name of organization running log(s): N/A

I certify that the well was drilled, constructed, and completed in accordance with all applicable requirements of the Mississippi Department of Environmental Quality and/or the Mississippi Department of Health regulations and state laws.


Jack Ridgell 0-472  
Print Name of Water Well Contractor and License No.

[Signature] MAR 13 2013  
Signature of Water Well Contractor

RECEIVED  
BY OLIVE

If well telescopes please sketch below and show depths.


Ground Level

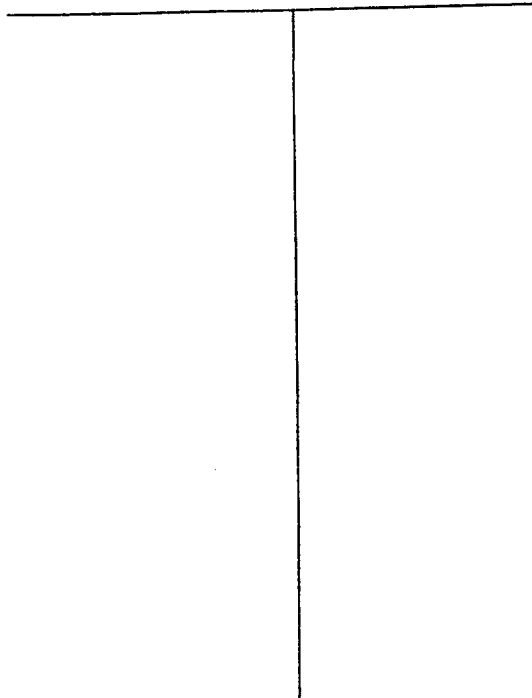

Description of Formations Encountered	From	To
TOP SOIL	0	2
Orange Clay	2	18
Orange Coarse Sand	18	30
Orange Clay	30	80
Orange Coarse Sand	80	90
Blue Clay	90	57
Gray Coarse Sand	57	76
Blue Clay	76	128
Gray Coarse Sand	128	183
Blue Clay	183	228
Gray Coarse Sand	228	800

If more than one screen, show location of each on sketch

Sketch the property layout and include the following: 1) the well location; 2) any permanent structures on the property that may aid in locating the well; 3) any roads, power lines, or other items that may aid in locating the property and the well; 4) indicate direction.

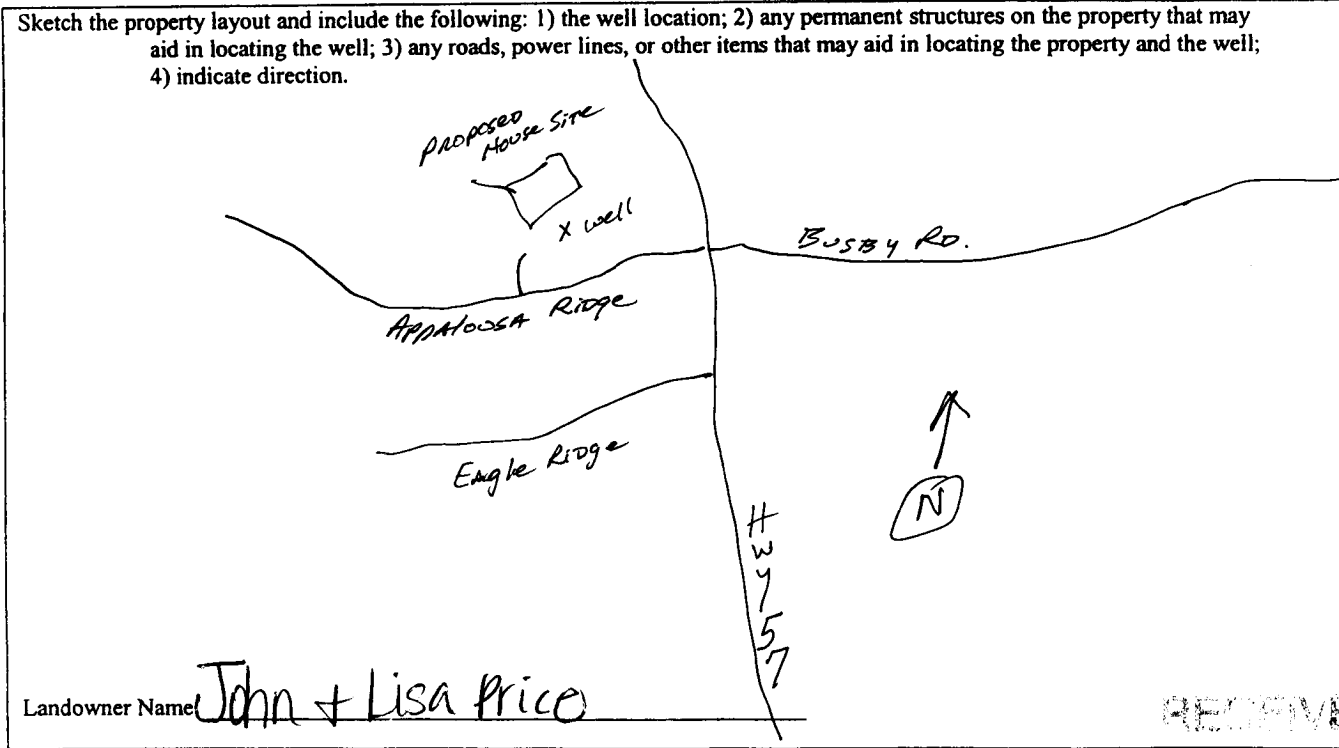

RECEIVED

MAR 13 2013

BY: OLWR

*John + Lisa Price*  
 Signature of Water Well Contractor

# STATE WELL REPORT

## Part 2

**Pump Installer's Completion Report**  
 Mississippi Department of Environmental Quality  
 Office of Land and Water Resources  
 P.O. Box 10631  
 Jackson, MS 39289-0631  
 (601) 961-5210  
 (601) 354-6938 (fax)

For Office Use Only:

Aquifer: \_\_\_\_\_  
 Well #: F472  
 Elevation: \_\_\_\_\_

County: Jackson  
 Permit #: \_\_\_\_\_  
 Driller: Coast Water Wells SA  
 Date completed: 3/2/13

**This report should be prepared by the pump installer in detail and filed with the Department within 30 days of the installation of pump.**

Well Owner Information	Well Location
Owner Name: <u>John + Lisa Price</u>	Latitude: <u>30° 36' 56.52"</u> Longitude: <u>88° 43' 35.16"</u>
Mailing Address: <u>Appalooosa Ridge</u>	Method of Lat/Long (circle one): Conventional Survey, USGS quad, <u>Hand-held GPS</u> , Survey-grade GPS
<u>Vancleave, Ms 39565</u>	<u>NW 1/4 NW 1/4 Sec 18 Twn T55 Rng R7W</u>
City State Zip Code	Distance Direction Nearest Town
Telephone No. <u>(228) 342-8995</u>	<u>6 1/4</u> Miles <u>NW</u> of <u>Vancleave</u>

Pump Type Circle one	Power Type Circle one
Air Lift <input type="radio"/> Jet <input checked="" type="radio"/> Submersible	Diesel Engine Gasoline Engine Natural Gas
Bucket <input type="radio"/> Piston <input type="radio"/> Turbine	<input checked="" type="radio"/> Electric Motor <input type="radio"/> Hand <input type="radio"/> Tractor PTO
Centrifugal <input type="radio"/> Rotary <input type="radio"/> Flowing Well	Windmill Other (specify): _____
Other (specify): _____	Horse Power Rating of Motor: <u>2 HP</u>
Date Pump Installed: <u>3/8/13</u>	Setting Depth: <u>120 FT. Drop pipe</u> feet
Rated Pump Capacity: <u>8</u> Gallons Per Minute	Number of Stages: <u>3</u>

Pump Test Data	Method of Measuring Water Level Circle one
Date Well Tested: <u>3/8/13</u>	<input checked="" type="radio"/> Air Line <input type="radio"/> Electric Measuring Line <input type="radio"/> Steel Tape
Static Water Level (A): <u>105</u> Feet Below Land Surface	Other (specify): _____
Pumping Water Level (B): <u>N/A</u> Feet Below Land Surface	For flowing well, measured shut in head: <u>N/A</u> feet
Drawdown [(B) - (A)]: <u>N/A</u> Feet Below Land Surface	Well yielded <u>24</u> GPM with a drawdown of
Test Pumping Rate: <u>8</u> Gallons Per Minute	<u>N/A</u> feet after <u>N/A</u> hours of pumping
Duration of Pump Test (minimum 4 hours): <u>5 1/4</u> hours	

I HEREBY CERTIFY that the above statements are true to the best of my knowledge.

Jack Ridgell 0-472 Jack Ridgell  
 Print Name of Pump Installer and License No. (if applicable) Signature of Pump Installer

RECEIVED  
 MAR 13 2013