C	TATE WELL REPORT	· · · · · · · · · · · · · · · · · · ·
county: JOCKSON	Part 1	For Office Use Only:
County: <u>CLBU</u>	Driller's Log	Well #: F491
Permit #: Mississi	ppi Department of Environmental Quality	Aquifer:
DIRET AND I WARE WARTSHE	Office of Land and Water Resources P.O. Box 2309	E-Log #:
Date drilling completed: <u>8-7-14</u>	Jackson, MS 39225-2309	L-LOS #
	(601)961-5210 (601)360-0535 (fax)	
	• •	to work and filed with the
State Law requires that this report be prepa Department at the above address within 30	ared by the license holder responsible for a days of completion of drilling of the well (ne work and jued with the or borehole.
Well Owner Information	Well or Bore	hole Location
(Landowner if borehole is not for a water W_{1}	Latitude: 2034 45.90 Lor	ngitude: 188 38' 19.42"
Owner Name: Michael Keen	Method of Lat/Long (check one	e): Conventional Survey,
Mailing Address: 1647901dKiverRD.	LOOP USGS guad Hand-held G	PS, Survey-grade GPS
10010 12 000 20015		40 T55 R7W
Vancleave MS 39565 City State		
	$\frac{472}{(\text{Distance})} \text{ Miles } \frac{102}{(\text{Distance})} \text{ (Distance)}$	(Nearest Town)
Telephone No. (228) 282-0600		(,,,,,,,,,,,,,,,,,,,,,,,,,,,,,,,,,,,,,,
	Well / Borehole Data	
Date drilling started: 8-7-14 Date drilling	completed: $8 - 7 - 14$ Hole depth: 311	\underline{FT} Hole diameter: \underline{J}
Location of the source of any surface water US	ed for drilling: N/A	
Method of dosing and volume of Chlorine used	in drilling and development: 1901 PLV []	poprilling Igalin Well
Logs run (circle all applicable) No log run Ele	ctric Gamma Ray Density Sonic Neutr	on Other:
Name of organization running log(s):		Ground Source Heat Pump
Purpose of borehole (circle one): Water Well		Ground Source near rump
Seismic Surve		
	water well construction, skip the remainde	
Purpose of Well (circle all applicable): Home	Industrial Public Supply Irrigation	Fish Culture
Other (describe):		
If a flowing well, method of flow regulation:	Valve Other (describe)	0.0.11
Static Water Level:feet [above (ci	e or below land surface Date measure	ed: <u>8-7-14</u>
Method of measurement (circle one): Steel tar		
Well depth: 31F Well grouted to a depth	of: 6 feet Type of grout (circle one): Neat Cement Bentonite Mix
Casing length:feet Casing di	ameter:inches Type of	casing: <u>PVC</u>
Screen length:feet Screen	diameter: <u>2</u> inches Type o	f screen:
Screen slot size: <u>COC</u> inches Se	etting depth: From <u>26</u> feet	tofeet
Type of completion (circle all applicable): Gra	wel packed Underreamed Open hole	e Natural Development
Other (describe):		
Top of lap pipe or reduction in casing:		
If telescoped of	more than one screen, describe on next p	page

., **t**

Form: OLWR-SWR-1A (4/13)

1:


County: 10C	KSON
Permit #:	

Fo	r Office	Use Only:
Well #: _	F49	(

The sketch below only required for water wells

Description of formations encountered must be provided for all wells and boreholes, unless specifically exempted by regulations

If well telescopes, show depths on sketch.			
	Description of Formations Encountered	From (depth)	To (depth)
Ground Level	Top Soil	Ground level	2
	Manae clay 1	$\left \mathcal{A} \right $	20
	Brouth Coarse Sana	20	31
	·		
	,		
		<i></i>	
1			
·		·	
			l
If more than one screen, show location of each on sketch	· · ·		

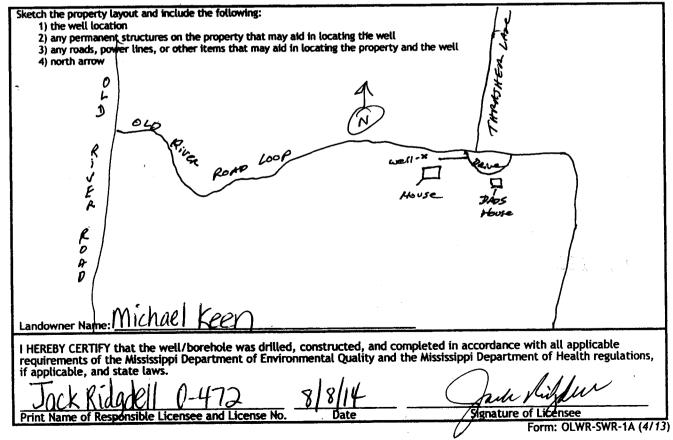

County: Jackson	VELL REPORT	
	Part 2	For Office Use Only:
remarky.	er's Completion Report	Well #: _ F491
	ment of Environmental Quality and and Water Resources	Well #:
Date completed: 8-7-14	P.O. Box 2309	Aquifer:
	ion, MS 39225-2309 (601)961-5210	Aquiter:
	1) 360-0535 (fax)	
This part of the report must be completed by a licensed wate	er well contractor or a licensed pur	up installer. A copy of Part 1
of the report must be attached and both parts filed with the	Department at the above address w	ithin 30 days of well completio
Owner Name: Wither Keet7	Well Li Latitude <u>3034'45,90"</u> Lon	
Mailing Address: 16479012 River RD Loof		
1/20/00/00 20515	USGS quad, Hand-held Gi	
Vancleave, m.s. 39565 City State Zip Code	New NW 4, Sec	40 T 55 R 74
	4/2 Miles NE of	Vancheme
Telephone No. (201) 282 - 0606	(Distance) (Direction)	(Nearest Town)
Pump Ty	pe (circle one)	
Submersible Turbine Air Lift Centrifugal Flowing Well		scribe):
Date Pump Installed: 8-7-14		
		Gallons Per Mini
Is This Pump (circle one): New Repaired Replaceme		
\bigcirc	ype (circle one)	•
Electric Diesel Gasoline Natural Gas Tractor PTO Wi	ndmill Other (<i>describe</i>):	· · · · · · · · · · · · · · · · · · ·
Horse Power Rating of Motor: Setting Dep	oth: <u>95FTDP_feet</u> Number	of Stages:
-	for Non Flowing Well	IC IC
Date Well Tested:		
Static Water Level (A): $\underline{30}$ Feet Below Land Surface	e Pumping Water Level (B):	NA Feet Below Land Surface
Drawdown [(B) - (A)]:N AFeet Below Land Sur	rface Test Pumping Rate:	8.5 Gallons Per Minu
Method of measurement (<i>circle one</i>): Steel tape Electric t		
	ta for Flowing Well	
Measured shut in head:		
	VA	
Well yielded GPM with a drawdown of	feet_after	hours of pumping
Meter	Installation	
Meter Manufacturer:	Meter Serial Number:	. •
N	1	
Meter Model Number/Name:/V		
Totalizer Register Unit and Multiplier Factor (AF x .001, ga	ıl x 1000, etc):	
Installation Date: Meter installed by:		
Installation Date: Meter installed by:		
Installation Date: Meter installed by: Is This Meter (circle one): New Repaired Replacem	ent	
Installation Date: Meter installed by: Is This Meter (circle one): New Repaired Replacem Important: By submitting the above information you are c	ent certifying that this meter was instal	led to manufacturer standards
Installation Date: Meter installed by: Is This Meter (circle one): New Repaired Replacem Important: By submitting the above information you are c For agricultural wells, a list of ap	ent sertifying that this meter was instal oproved meters is on the MDEQ we	led to manufacturer standards
Installation Date: Meter installed by: Is This Meter (circle one): New Repaired Replacem Important: By submitting the above information you are c	ent certifying that this meter was instal pproved meters is on the MDEQ we he best of my knowledge.	led to manufacturer standards obsite.
Installation Date: Meter installed by: Is This Meter (circle one): New Repaired Replacem Important: By submitting the above information you are c For agricultural wells, a list of ap	ent certifying that this meter was instal pproved meters is on the MDEQ we he best of my knowledge.	led to manufacturer standards obsite.
Installation Date: Meter installed by: Is This Meter (circle one): New Repaired Replacem Important: By submitting the above information you are c For agricultural wells, a list of ap	rent rertifying that this meter was instal pproved meters is on the MDEQ we he best of my knowledge.	led to manufacturer standards

.

•.