

# STATE WELL REPORT

## Part 1

### Driller's Log

Mississippi Department of Environmental Quality  
Office of Land and Water Resources  
P.O. Box 2309  
Jackson, MS 39225-2309  
(601)961-5210  
(601)360-0535 (fax)

County: Jackson  
 Permit #: \_\_\_\_\_  
 Driller: East Waterwell SVC  
 Date drilling completed: 8-3-15

**For Office Use Only:**

Well #: F500  
 Aquifer: \_\_\_\_\_  
 E-Log #: \_\_\_\_\_

*State Law requires that this report be prepared by the license holder responsible for the work and filed with the Department at the above address within 30 days of completion of drilling of the well or borehole.*

| Well Owner Information<br><small>(Landowner if borehole is not for a water well)</small> | Well or Borehole Location  |
|--|--|
| Owner Name: <u>Jason Butler</u>  | Latitude: <u>30°35'2.76"</u> Longitude: <u>088°38'42.12"</u>   |
| Mailing Address: <u>Edberg Blvd.</u>   | Method of Lat/Long (check one): Conventional Survey _____, USGS quad _____, Hand-held GPS <input checked="" type="checkbox"/> , Survey-grade GPS _____ |
| <u>Vancleave, MS 39565</u>   | <u>SW</u> ¼ <u>NW</u> ¼, Sec <u>25</u> T <u>55</u> R <u>7W</u>   |
| City State Zip Code  | <u>4.814</u> Miles <u>NE</u> of <u>Vancleave</u>   |
| Telephone No. <u>(228) 217-8389</u>  | (Distance) (Direction) (Nearest Town)  |

**Well / Borehole Data**

Date drilling started: 8-3-15 Date drilling completed: 8-3-15 Hole depth: 210 FT Hole diameter: 2"

Location of the source of any surface water used for drilling: N/A

Method of dosing and volume of Chlorine used in drilling and development: 1 gal per 1000 drilling gal in well

Logs run (circle all applicable):  No log run  Electric  Gamma Ray  Density  Sonic  Neutron  Other: \_\_\_\_\_

Name of organization running log(s): \_\_\_\_\_

Purpose of borehole (circle one):  Water Well  Geotechnical/Geological Investigation  Ground Source Heat Pump  
 Seismic Survey  Other (describe) \_\_\_\_\_

*If drilling is not related to water well construction, skip the remainder of this block*

Purpose of Well (circle all applicable):  Home  Industrial  Public Supply  Irrigation  Fish Culture

Other (describe): \_\_\_\_\_

If a flowing well, method of flow regulation: Valve \_\_\_\_\_ Other (describe) \_\_\_\_\_

Static Water Level: 105 feet [above or  below] land surface Date measured: 8-3-15

Method of measurement (circle one): Steel tape  Electric tape   Air line  Other (describe): \_\_\_\_\_

Well depth: 210 FT Well grouted to a depth of: 10 feet Type of grout (circle one): Neat Cement   Bentonite  Mix

Casing length: 200 feet Casing diameter: 2 inches Type of casing: PVC

Screen length: 10 feet Screen diameter: 2 inches Type of screen: PVC

Screen slot size: .006 inches Setting depth: From 200 feet to 210 feet

Type of completion (circle all applicable): Gravel packed  Underreamed  Open hole   Natural Development

Other (describe): \_\_\_\_\_

Top of lap pipe or reduction in casing: N/A feet

*If telescoped or more than one screen, describe on next page*

AUG 17 2015


County: JACKSON  
Permit #: \_\_\_\_\_

**For Office Use Only:**  
Well #: F500

The sketch below only required for water wells

If well telescopes, show depths on sketch.


Ground Level →

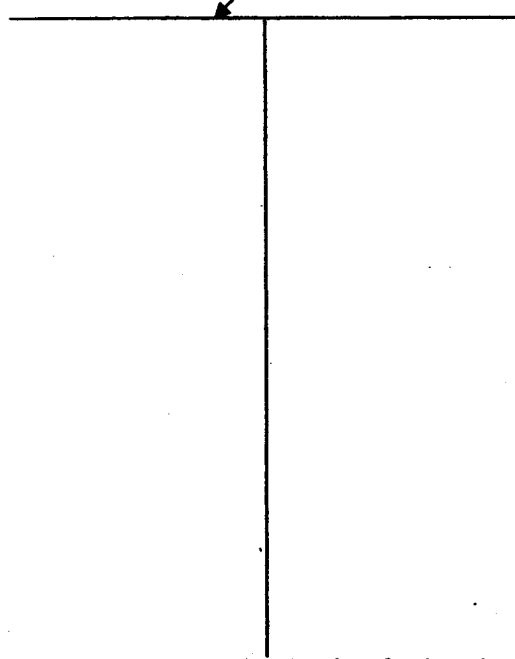

Description of formations encountered must be provided for all wells and boreholes, unless specifically exempted by regulations

| Description of Formations Encountered | From (depth) | To (depth) |
|---------------------------------------|--------------|------------|
| TOPSOIL                               | Ground level | 2          |
| Orange Clay                           | 2            | 10         |
| Brown Coarse Sand                     | 10           | 25         |
| Blue Clay                             | 25           | 185        |
| Gray Medium Sand                      | 185          | 210        |
|                                       |              |            |
|                                       |              |            |
If more than one screen, show location of each on sketch

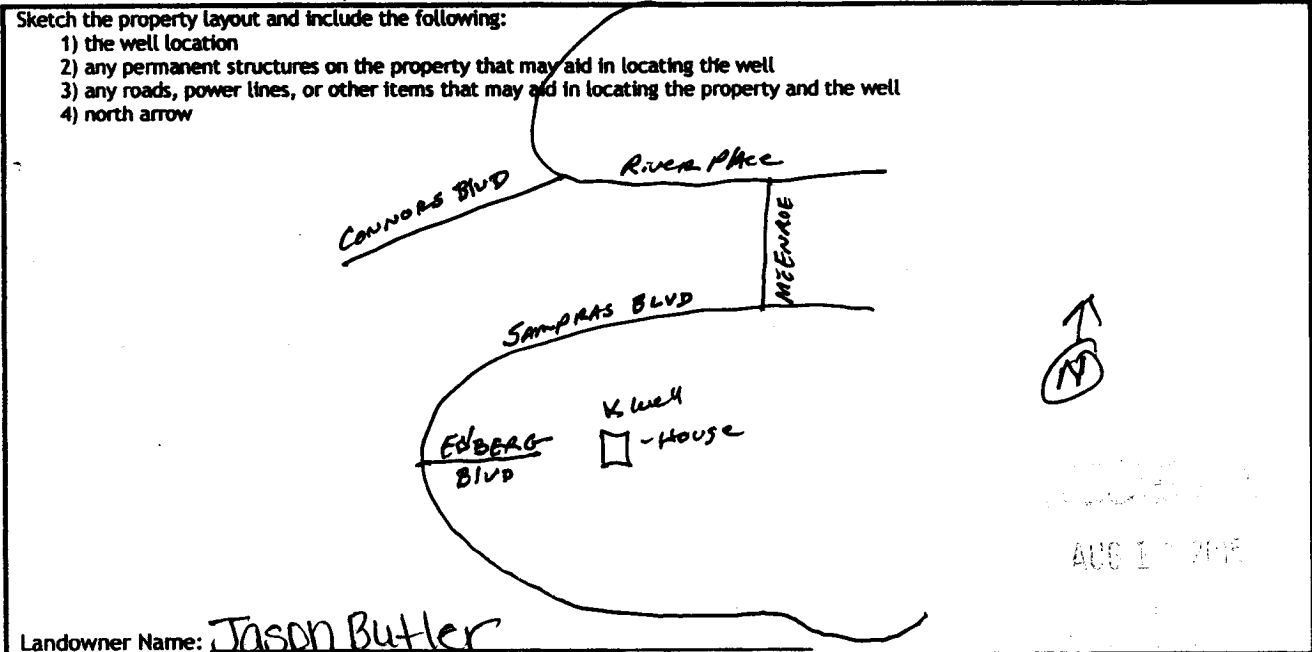

Landowner Name: Jason Butler

I HEREBY CERTIFY that the well/borehole was drilled, constructed, and completed in accordance with all applicable requirements of the Mississippi Department of Environmental Quality and the Mississippi Department of Health regulations, if applicable, and state laws.

Jack Ridadell 0-472 8/6/15  
Print Name of Responsible Licensee and License No.      Date

[Signature]  
Signature of Licensee

# STATE WELL REPORT

## Part 2

**Pump Installer's Completion Report**  
Mississippi Department of Environmental Quality  
Office of Land and Water Resources  
P.O. Box 2309  
Jackson, MS 39225-2309  
(601)961-5210  
(601) 360-0535 (fax)

County: Jackson  
Permit #: \_\_\_\_\_  
Driller: Coast Water Wells Inc  
Date completed: 8-3-15  
*Copy information from block on Part 1*

**For Office Use Only:**  
Well #: F500  
Aquifer: \_\_\_\_\_

*This part of the report must be completed by a licensed water well contractor or a licensed pump installer. A copy of Part 1 of the report must be attached and both parts filed with the Department at the above address within 30 days of well completion.*

| Well Owner Information                | Well Location  |
|---------------------------------------|--|
| Owner Name: <u>Jason Butler</u>       | Latitude: <u>30° 35' 2.76"</u> Longitude: <u>088° 38' 42.12"</u>   |
| Mailing Address: <u>Edberg Blvd.</u>  | Method of Lat/Long (check one): Conventional Survey _____, USGS quad _____, Hand-held GPS <input checked="" type="checkbox"/> , Survey-grade GPS _____ |
| <u>Vanceleave, MS 39565</u>           | <u>SW 1/4 NW 1/4, Sec 25 T 55 R 7W</u>   |
| City _____ State _____ Zip Code _____ | <u>4 1/4</u> Miles <u>NE</u> of <u>Vanceleave</u>  |
| Telephone No. <u>(601) 217-8389</u>   | (Distance) (Direction) (Nearest Town)  |

**Pump Type (circle one)**  
Submersible Turbine Air Lift Centrifugal Flowing Well  Jet  Piston  Rotary  Other (describe): \_\_\_\_\_  
Date Pump Installed: 8-4-15 Rated Pump Capacity: 7.5 Gallons Per Minute  
Is This Pump (circle one):  New  Repaired  Replacement

**Power Type (circle one)**  
 Electric  Diesel  Gasoline  Natural Gas  Tractor PTO  Windmill  Other (describe): \_\_\_\_\_  
Horse Power Rating of Motor: 2 HP Setting Depth: 100 FT. feet Number of Stages: 3

**Pump Test Data for Non Flowing Well**  
Date Well Tested: 8-4-15 Duration of Pump Test (minimum 4 hours): 4 1/2 hours  
Static Water Level (A): 105 Feet Below Land Surface Pumping Water Level (B): N/A Feet Below Land Surface  
Drawdown [(B) - (A)]: N/A Feet Below Land Surface Test Pumping Rate: 7.5 Gallons Per Minute  
Method of measurement (circle one): Steel tape  Electric tape  Air line  Other (describe): \_\_\_\_\_

**Pump Test Data for Flowing Well**  
Measured shut in head: \_\_\_\_\_ feet. N/A  
Well yielded \_\_\_\_\_ GPM with a drawdown of \_\_\_\_\_ feet after \_\_\_\_\_ hours of pumping

**Meter Installation**  
Meter Manufacturer: \_\_\_\_\_ Meter Serial Number: \_\_\_\_\_  
Meter Model Number/Name: N/A Type of Meter: \_\_\_\_\_  
Totalizer Register Unit and Multiplier Factor (AF x .001, gal x 1000, etc): \_\_\_\_\_  
Installation Date: \_\_\_\_\_ Meter installed by: \_\_\_\_\_  
Is This Meter (circle one):  New  Repaired  Replacement  
*Important: By submitting the above information you are certifying that this meter was installed to manufacturer standards. For agricultural wells, a list of approved meters is on the MDEQ website.*

I HEREBY CERTIFY that the above statements are true to the best of my knowledge.  
Jack Riddell 0-472 8/16/15 Jack Riddell  
Print Name of Pump Installer and License No. (if applicable) Date Signature of Pump Installer