

JACKSON
 F 2003
 9/4/76

MISSISSIPPI
 BOARD OF WATER COMMISSIONERS
 416 North State Street
 130 Jackson, Mississippi 39201

WATER WELL DRILLERS LOG

9/4 1976 Coast Water Well Dr. Jackson
 date well completed firm name county well located

LANDOWNER: <u>Casley, McPhilly</u>	Description of formations encountered	from	to
<u>P.O. Box 2</u>	<u>top soil</u>	<u>0</u>	<u>5</u>
<u>Paint Clear Ala</u> (mailing address)	<u>red clay</u>	<u>5</u>	<u>39</u>
WELL LOCATION: sec. <u>29</u> T <u>5</u> S R <u>7</u> E W	<u>Coarse red sand</u>	<u>39</u>	<u>105</u>
<u>3 1/2</u> miles <u>N</u> of <u>Vandover</u> (distance) (direction) (nearest town)	<u>blue clay</u>	<u>105</u>	<u>230</u>
WELL PURPOSE: <u>Home</u> (home, irrigation, municipal, industrial)	<u>grey clay</u>	<u>230</u>	<u>285</u>
WELL COMPLETION DATA:			
(1) diameter (inches) <u>2"</u>			
(2) total depth (feet) <u>285'</u>			
(3) static water level (feet) <u>57</u> <u>below</u> top of ground. <u>shore</u>			
(4) casing <u>PVC</u> , <u>275'</u> (material) (depth) <u>2"</u> (size) If telescope see back.			
(5) screen <u>10'</u> , <u>275'</u> (length) (depth to top) <u>2"</u> , <u>PVC</u> (size) (material)			
(6) pump _____ (HP) (yield gpm) (type power)			
(7) electric log <u>NO</u> (yes or no) (organization running log)			
(8) how well bottom plugged <u>blw debris</u>			
DRILLERS REMARKS:			


RECEIVED

MAR - 9 1977

MISS. BD. OF WATER COMM

If well telescopes please sketch and show depths.

GROUND LEVEL

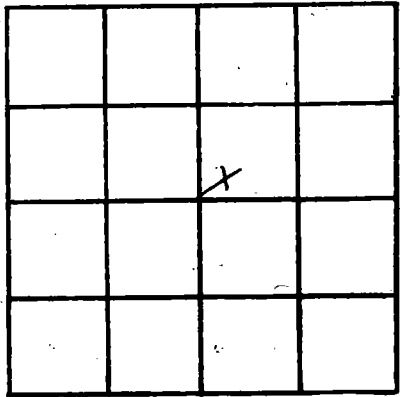

SECTION 29

Please indicate well location X.

ADDITIONAL INFORMATION:

If more than one screen, show locations of each on sketch.