

JACKSON  
 F 2005  
 1-28-77

MISSISSIPPI  
 BOARD OF WATER COMMISSIONERS  
 416 North State Street  
 132 Jackson, Mississippi 39201

WATER WELL DRILLERS LOG  
 COAST WATER WELL SERVICE

1-28 1977 date well completed  
 firm name  
 Jackson county well located

LANDOWNER: James Payne  
 Rt 2 - Box P-43  
 Ocean Springs, Miss  
 (mailing address) 39164

description of formations encountered	from	to
Top Soil	0	2
Red Clay	2	32
Sand (med)	32	51
White Clay	51	55
Sand (med course)	55	100
Blue Clay	100	225
Sand (med course)	225	278

WELL LOCATION:  
 sec 29 T 5 S R 7 E  
 S W  
 3 1/2 miles N of Vancleave  
 (distance) (direction) (nearest town)

WELL PURPOSE: Home  
 (home, irrigation, municipal, industrial)

WELL COMPLETION DATA:

(1) diameter (inches) - 2 -  
 (2) total depth (feet) 278  
 (3) static water level (feet) 65 below top of ground.  
 (4) casing PVC, 268, (material) (depth)  
 - 2 - If telescope see back. (size)  
 (5) screen 10, 268 (length) (depth to top)  
 2, PVC (size) (material)  
 (6) pump 2 HP, 7 (HP) (yield gpm)  
 Elect. (type power)  
 (7) electric log No (yes or no)  
 (organization running log)

(8) how well bottom plugged backwash  
 valve


DRILLERS REMARKS:

RECEIVED  
 MAR 11 1977

MISS. BD. OF WATER COMMISSIONERS

If well telescopes please sketch and show depths.

GROUND LEVEL

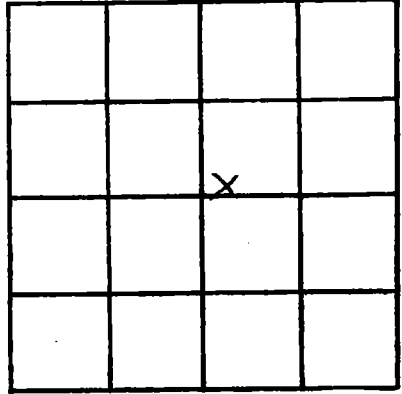

SECTION 29

Please indicate well location X.

ADDITIONAL INFORMATION

If more than one screen, show locations of each on sketch.