

JACKSON  
 F 2006  
 2-5-77

MISSISSIPPI  
 BOARD OF WATER COMMISSIONERS  
 416 North State Street  
 130 Jackson, Mississippi 39201

WATER WELL DRILLERS LOG

COAST WATER WELL SERVICE

2-5 1977  
 date well completed

firm name

Jackson  
 county well located

LANDOWNER: Cornelius Moore

description of formations encountered

from to

Rt 2 - Box 228 B -  
Ocean Springs, Miss  
 (mailing address) 39564

Top Soil	0	2
Red Clay	2	76
Sand (Medium)	76	129

WELL LOCATION:

sec. 20 T. 5 S. R. 7 W.  
4 miles N. of Thachau  
 (distance) (direction) (nearest town)

WELL PURPOSE: Home  
 (home, irrigation, municipal, industrial)

WELL COMPLETION DATA:

- (1) diameter (inches) 2
- (2) total depth (feet) 129
- (3) static water level (feet) 65' <sup>below</sup> <sub>above</sub> top of ground.
- (4) casing PVC, 119  
 (material) (depth)  
2 If telescope see back.  
 (size)
- (5) screen 10, 119  
 (length) (depth to top)  
2, P.V.C.  
 (size) (material)
- (6) pump 1 hp., 5'12  
 (HP) (yield gpm)  
Electric  
 (type power)
- (7) electric log No  
 (yes or no)

(organization running log)

(8) how well bottom plugged Backwash  
Value


DRILLERS REMARKS:

RECEIVED  
 MAR - 9 1977

MISSISSIPPI BOARD OF WATER COMMISSIONERS

If well telescopes please sketch and show depths.

GROUND LEVEL

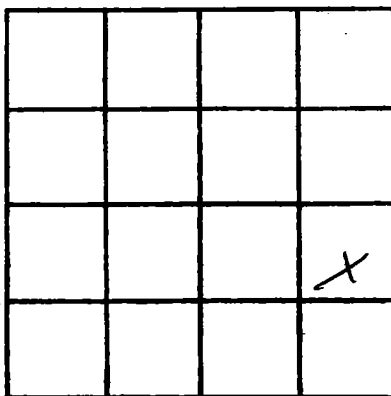

SECTION 20

Please indicate well location X.

ADDITIONAL INFORMATION

If more than one screen,  
show locations of each on sketch.