

JACKSON
 F 2007
 3-3-77

MISSISSIPPI
 BOARD OF WATER COMMISSIONERS
 416 North State Street
 Jackson, Mississippi 39201

WATER WELL DRILLERS LOG

3-3
 date well completed

132 77 Coast Water Well Inc
 firm name

Jackson
 county well located

LANDOWNER: D. B. Helton
 Vanclave Baptist Mission
 1609 Cedar Point
 Gautier, Mo. 39553
 (mailing address)

description of formations encountered	from	to
top soil	0	1
red clay	1	18
Med. to coarse sand	18	45
red clay	45	64
med to coarse sand	64	130
blue clay	130	160
med. sand	160	174
blue clay	174	190
Med. to coarse sand	190	215

WELL LOCATION:

sec. 19 T 5 S R 7 W
 4 miles N of Vanclave
 (distance) (direction) (nearest town)

WELL PURPOSE: Church
 (home, irrigation, municipal, industrial)

WELL COMPLETION DATA:

- (1) diameter (inches) 2"
- (2) total depth (feet) 215
- (3) static water level (feet) 65 ^{below} ~~above~~ top of ground.
- (4) casing PVC, 205' (material) (depth)
 2" (size) If telescope see back.
- (5) screen 10' 205' (length) (depth to top)
 2" PVC (size) (material)
- (6) pump 1 1/2 HP 8 1/2 (yield gpm)
 elec. (type power)
- (7) electric log NO (yes or no)
 (organization running log)
- (8) how well bottom plugged Blue Water


RECEIVED
 MAR 11 1977

DRILLERS REMARKS:

MISS. BD. OF WATER COMM

If well telescopes please sketch and show depths.

GROUND LEVEL

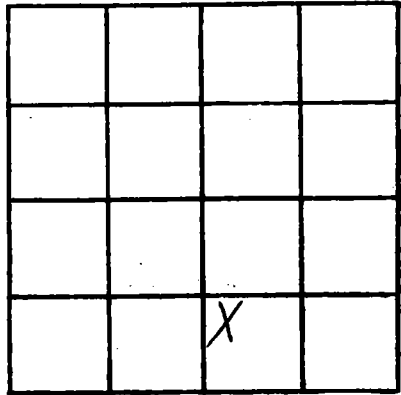

SECTION 19

Please indicate well location X.

ADDITIONAL INFORMATION

If more than one screen,
show locations of each on sketch.