

JACKSON  
 F 2009  
 4-27-77

MISSISSIPPI  
 BOARD OF WATER COMMISSIONERS  
 416 North State Street  
 Jackson, Mississippi 39201

WATER WELL DRILLERS LOG  
 COASTAL DRILLING & SERVICE CO.

4/27/77  
 date well completed

ROUTE 1 BOX 618  
 farm name

Jackson  
 county well located

LANDOWNER: Wye Shaw  
 Rt 2 Box 140A  
 Ocean Springs, Miss  
 (mailing address)

description of formations encountered	from	to
Top Soil	1	3
Red clay	3	16
white sand	16	30
Soft Blue Clay	30	180
fine white sand	180	215
Coarse white sand	215	235

WELL LOCATION:  
 sec 23 T. 5 N R. 7 E  
 3 1/2 NE 1/4 of section 3  
 (distance) (direction) of (nearest town)

WELL PURPOSE: Home  
 (home, irrigation, municipal, industrial)

- WELL COMPLETION DATA:
- (1) diameter (inches) 2"
  - (2) total depth (feet) 235'
  - (3) static water level (feet) 80' below top of ground
  - (4) casing pk 225'  
 (material) (depth)
  - (5) screen 10' 225'  
 (length) (depth to top)  
2" pk  
 (size) (material)
  - (6) pump One 10  
 (HP) (yield gpm)  
Ele  
 (type power)
  - (7) electric log no  
 (yes or no)
- (organization running log)

(8) how well bottom plugged  
2' pack with water


DRILLERS REMARKS:

RECEIVED  
 JUN 16 1977

MISS. BD. OF WATER COMM.

If well telescopes please sketch and show depths.

GROUND LEVEL

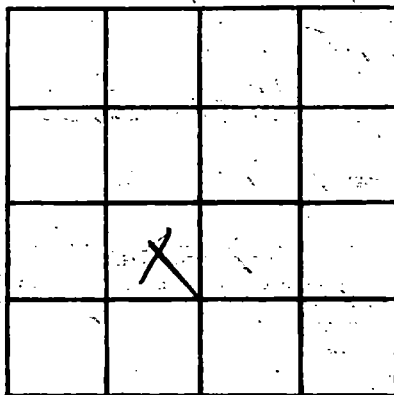

SECTION \_\_\_\_\_

Please indicate well location X.

ADDITIONAL INFORMATION

If more than one screen, show locations of each on sketch.