

JACKSON

F 2814

MISSISSIPPI BOARD OF WATER COMMISSIONERS
416 North State Street
Jackson, Mississippi 39201


WATER WELL DRILLERS LOG

3-3-78 date well completed
78 Coast Water Well Sub. firm name
Jackson county well located

LANDOWNER: T. N. Ladner

Rt 2 - Box 229C
Ocean Springs, Miss.
(mailing address) 39564

WELL LOCATION:

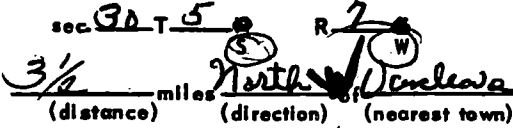

WELL PURPOSE: Home
(home, irrigation, municipal, industrial)

WELL COMPLETION DATA:

- (1) diameter (inches) 4"
- (2) total depth (feet) 310'
- (3) static water level (feet) 85' ^{below} _{above} top of ground.
- (4) casing P.V.C., 290'
(material) (depth)
- 4" X 2" If telescope see back.
(size)
- (5) screen 20' 290'
(length) (depth to top)
- P.V.C.
(size) (material)
- (6) pump 1 H.P. 25
(HP) (yield gpm)
- Elect
(type power)
- (7) electric log No
(yes or no)
- (organization running log)

(8) hole well bottom plugged
backwash valve

description of formations encountered	from	to
Top soil	0	3
Red Clay	3	30
Sand (mc)	30	60
Red Clay	60	82
Sand gravel	82	184
Blue Clay	184	200
Sand (F)	200	215
Blue Clay	215	281
Sand (mc)	281	310

RECEIVED


MAY 30 1978

MISS. BO. OF WATER COM.

DRILLERS REMARKS:

If well telescopes please sketch and show depths.

GROUND LEVEL

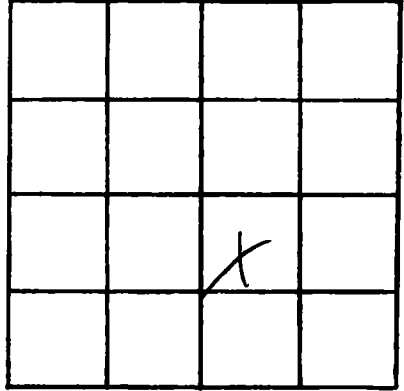

SECTION 30

Please indicate well location X.

ADDITIONAL INFORMATION

If more than one screen, show locations of each on sketch.