

JACKSON  
 F 2024  
 6-27-79

MISSISSIPPI  
 BOARD OF WATER COMMISSIONERS  
 416 North State Street  
 Jackson, Mississippi 39201

WATER WELL DRILLERS LOG

6-27-79 date well completed  
 Coastal Water Well Serv. Inc. firm name  
 Jackson county well located

LANDOWNER: (mailing address)	description of formations encountered	from	to
		Gary Noble Rt 4 - Box 94 N Ocean Springs, Miss. 38564	Top soil Red Clay Sand (m) Blue Clay Sand (m) Blue Clay Sand (m)

WELL LOCATION:

sec. 30 T. 5 R. 2  
 3 1/2 miles North Vandeventer  
 (distance) (direction) (nearest town)

WELL PURPOSE: Home  
 (home, irrigation, municipal, industrial)

WELL COMPLETION DATA:

- (1) diameter (inches) 2"
  - (2) total depth (feet) 290'
  - (3) static water level (feet) 95' below top of ground
  - (4) casing PVC 280' (material) (depth)  
 2" (size) if telescope see back.
  - (5) screen 10' 280' (length) (depth to top)  
 2" (size) PVC (material)
  - (6) pump 2hp 4 (HP) (yield gpm)  
 Elec. (type power)
  - (7) electric log No (yes or no)
- (organization running log)

DEPT. OF NATURAL RESOURCES  
 BUREAU OF LAND & WATER RESOURCES

JAN 25 1980


(8) how well bottom plugged  
 back wash valve

DRILLERS REMARKS:

RECEIVED

If well telescopes please sketch and show depths.

GROUND LEVEL

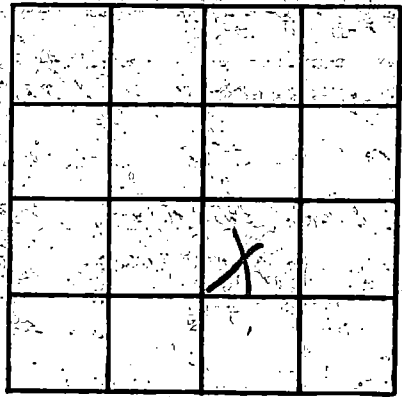

SECTION 30

Please indicate well location X.

ADDITIONAL INFORMATION

If more than one screen, show locations of each on sketch.