

MISSISSIPPI DEPARTMENT OF NATURAL RESOURCES

Bureau of Land and Water Resources

Southport Mall

P.O. Box 10631

Jackson, Mississippi 39209

WATER WELL DRILLERS LOG

JACKSON  
F 7032  
4-30-81  
4-30-81

date well completed: 4-30-81  
firm name: Coast Water Well Serv. Inc.  
county well located: Jackson

LANDOWNER: Mrs. Krupp  
Rt 2, Box 11 F  
Ocean Springs, Miss.  
(mailing address) 39564

WELL LOCATION:  
sec 36 T 5 S R 7 E  
3 1/2 miles NE of VAN CLEAVE  
(distance) (direction) (nearest town)

WELL PURPOSE: None  
(home, irrigation, municipal, industrial)

WELL COMPLETION DATA:  
(1) diameter (inches) 2"  
(2) total depth (feet) 210'  
(3) static water level (feet) 60' below top of ground.  
(4) casing PVC, 200' (material) (depth)  
3" (size) if telescope see back.  
(5) screen 10' (length), 200' (depth to top)  
2" (size), PVC (material)  
(6) pump 1/2 HP, 9 1/2 (yield gpm)  
Elect. (type power)  
(7) electric log No. (yes or no)  
(organization running log)  
(8) how well bottom plugged  
Back wash valve

description of formations encountered	from	to
Top soil	0'	2'
A. Clay	2'	20'
M. Sand	20'	35'
B. Clay	35'	175'
O. Sand	175'	210'

DEPT. OF NATURAL RESOURCES  
BUREAU OF LAND & WATER RESOURCES


JUN 2 - 1981

RECEIVED

DRILLERS REMARKS:

If well telescopes please sketch and show depths.

GROUND LEVEL

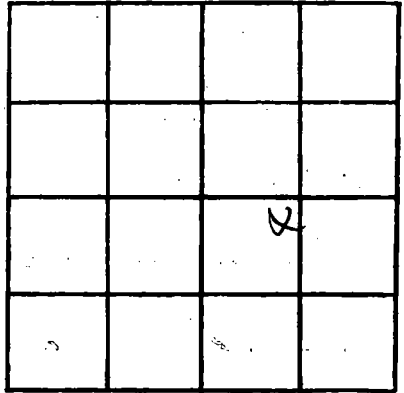

SECTION 36

Please indicate well location X.

ADDITIONAL INFORMATION

A series of horizontal lines for writing additional information, starting below the 'ADDITIONAL INFORMATION' header and extending to the bottom of the page.

If more than one screen, show locations of each on sketch.