

MISSISSIPPI DEPARTMENT OF NATURAL RESOURCES

Bureau of Land and Water Resources

Southport Mall

P.O. Box 10631

Jackson, Mississippi 39209

WATER WELL DRILLERS LOG

JACKSON
F 2033
8-6-81

8-6-81-19 Cross Water Well Serv. Inc. Jackson
date well completed firm name county well located

LANDOWNER: Smith Home, Inc.
Kenny Smith -
P.O. Box 1476
Pascagoula, Miss.
(mailing address) 39567

description of formations encountered	from	to
<u>Top soil</u>	<u>0</u>	<u>2'</u>
<u>B. Clay</u>	<u>2'</u>	<u>40'</u>
<u>M. Sand</u>	<u>40'</u>	<u>110'</u>
<u>B. Clay</u>	<u>110'</u>	<u>215'</u>
<u>M. Sand</u>	<u>215'</u>	<u>270'</u>

WELL LOCATION:

sec. 20 T-5 S R-7 W
4 1/2 miles N of VAN CLEAVE
(distance) (direction) (nearest town)


WELL PURPOSE: Home
(home, irrigation, municipal, industrial)

WELL COMPLETION DATA:

- (1) diameter (inches) 2"
- (2) total depth (feet) 270
- (3) static water level (feet) 80 below top of ground.
- (4) casing PVC, 260'
(material) (depth)
- 2" If telescope see back.
(size)
- (5) screen 10', 260'
(length) (depth to top)
- 2", PVC
(size) (material)
- (6) pump 1 hp, 4 1/2
(HP) (yield gpm)
- Elect.
(type power)
- (7) electric log No.
(yes or no)
- (organization running log)

(8) How well bottom plugged
Pack wash Valve

DRILLERS REMARKS:

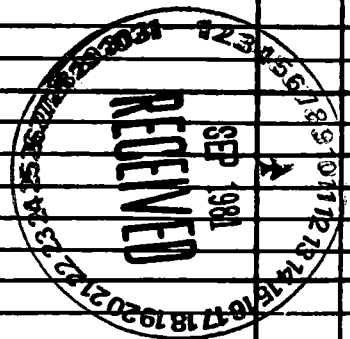

If well telescopes please sketch and show depths.

GROUND LEVEL

			X

SECTION 20

Please indicate well location X.

ADDITIONAL INFORMATION

If more than one screen, show locations of each on sketch.