

MISSISSIPPI DEPARTMENT OF NATURAL RESOURCES

Bureau of Land and Water Resources

Southport Mall

P.O. Box 10631

Jackson, Mississippi 39209

WATER WELL DRILLERS LOG

JACKSON
F 2034
8-10-81

8-10- date well completed
81 Coast Water Well Sew. firm name
Jackson county well located


LANDOWNER: James Myers
Box 2 - Box P. 71
Ocean Springs, Miss.
(mailing address) 32564

WELL LOCATION:
sec 20 T. 5 N R. 7 E
4 1/2 miles NW of VANCELAND
(distance) (direction) (nearest town)

WELL PURPOSE: none
(home, irrigation, municipal, industrial)

WELL COMPLETION DATA:
(1) diameter (inches) 2"
(2) total depth (feet) 260'
(3) static water level (feet) 68' (below top of ground)
(4) casing PVC 250' (material) (depth)
2" (size) if telescope see back.
(5) screen 10' 250' (length) (depth to top)
2" PVC (size) (material)
(6) pump 1/2 HP 8 (type power) (yield gpm)
Elect. (type power)
(7) electric log No. (yes or no)
(organization running log)
(B) how well bottom plugged
Back Wash Valve


description of formations encountered	from	to
Top soil	0	7'
Red Clay	7'	15'
Blue Clay	15'	70'
Red fine sand	70'	90'
Blue Clay & streak of sand	90'	130'
Blue Clay	130'	217'
gray coarse sand	217'	260'

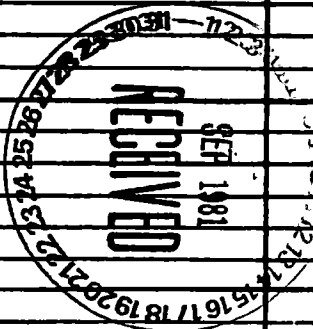

DRILLERS REMARKS:

If well telescopes please sketch and show depths.

GROUND LEVEL

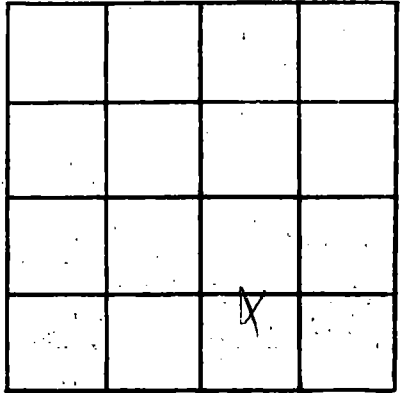

SECTION 20

Please indicate well location X.

ADDITIONAL INFORMATION

If more than one screen,
show locations of each on sketch.