

MISSISSIPPI DEPARTMENT OF NATURAL RESOURCES
Bureau of Land and Water Resources
 Southport Mall
 P.O. Box 10631
 Jackson, Mississippi 39209
WATER WELL DRILLERS LOG

JACKSON
F 2036
8-25-81

8-25-81 19 Cross Water Well Sew. Inc. Jackson
 date well completed firm name county well located

LANDOWNER Janneth Bourne
PO Box 6
Pascagoula, Miss.
 (mailing address) 39567

description of formations encountered	from	to
Top soil	0	2'
Red Clay	2	87
Red Med. sand	87'	110'
Blue Clay	110'	214'
Gray med. sand	214'	236'
Gray coarse sand	236'	260'

WELL LOCATION:
 sec. 19 T. 5 N. R. 7 E
4 3/4 miles NW of VAN CLEAVE
 (distance) (direction) (nearest town)

WELL PURPOSE:
 (home, irrigation, municipal, industrial)


- WELL COMPLETION DATA:
- diameter (inches) 2"
 - total depth (feet) 260'
 - static water level (feet) 23' below above top of ground.
 - casing PVC, 250'
 (material) (depth)
2" if telescope see back.
 (size)
 - screen 10', 250'
 (length) (depth to top)
2", PVC
 (size) (material)
 - pump 2 hp., _____
 (HP) (yield gpm)
Elect.
 (type power)
 - electric log No
 (yes or no)
- _____
 (organization running log)

(8) how well bottom plugged, back wash valve

DRILLERS REMARKS:

If well telescopes please sketch and show depths.

GROUND LEVEL

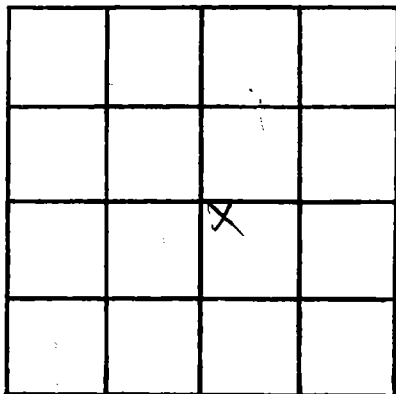

SECTION 29

Please indicate well location X.

ADDITIONAL INFORMATION

If more than one screen, show locations of each on sketch.