

MISSISSIPPI DEPARTMENT OF NATURAL RESOURCES

Bureau of Land and Water Resources

Southport Mall

P.O. Box 10631

Jackson, Mississippi 39209

WATER WELL DRILLERS LOG

JACKSON
F 2037
4-27-81

8-27-81
date well completed

Coast Water Well Service, Jackson
firm name

county well located

LANDOWNER: Roy Barnes
1008 Boys Road
Gautier, Miss.
(mailing address) 39553

description of formations encountered	from	to
Top soil	0	2'
Red Clay	2'	45'
Gray Clay	45'	70'
Blue Clay	70'	82'
Red med sand	82'	136'


WELL LOCATION:
sec. 19 T-5 S R-7 E
4 1/2 miles NW of Landmark
(distance) (direction) (nearest town)

Blue Clay	136'	195'
-----------	------	------

WELL PURPOSE: Home
(home, irrigation, municipal, industrial)

- WELL COMPLETION DATA:
- (1) diameter (inches) 2"
 - (2) total depth (feet) 383'
 - (3) static water level (feet) 114' below top of ground
 - (4) casing PVC 373' (material) (depth)
2" (size) If telescope see back.
 - (5) screen 10' 373' (length) (depth to top)
2" (size) PVC (material)
 - (6) pump 2 h.p. 5 1/2 (HP) (yield gpm)
Elec. (type power)
 - (7) electric log No. (yes or no)
 - (8) how well bottom plugged Back Wash Valve


Blue fine sand	195'	217'
Blue Clay & streak of sand	217'	260'
Gray med. sand	260'	280'
Gray coarse sand	280'	306'
Blue Clay	306'	311'
Gray coarse sand	311'	383'

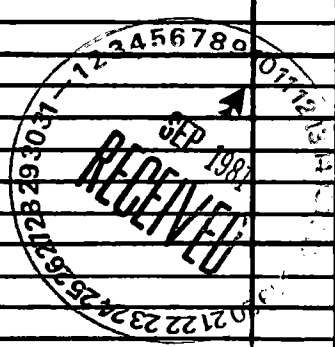

DRILLERS REMARKS:

If well telescopes please sketch and show depths.

GROUND LEVEL

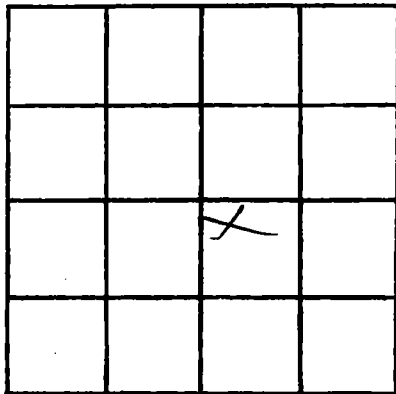

SECTION 19

Please indicate well location X.

ADDITIONAL INFORMATION

If more than one screen, show locations of each on sketch.