

MISSISSIPPI DEPARTMENT OF NATURAL RESOURCES

Bureau of Land and Water Resources

Southport Mall

P.O. Box 10631

Jackson, Mississippi 39209

WATER WELL DRILLERS LOG

JACKSON
Ph-462-4864
F 2039
9-18-81

Sept 17, 81 date well completed
Coast Water Well Serv. Inc. firm name
Jackson county well located

LANDOWNER: Eric M. Moore
P.O. Box 1013
Pascagoula, Miss.
(mailing address) 39567

WELL LOCATION:
sec. 29 T. 5 S. R. 7 E
4 miles NW of Vancleave
(distance) (direction) (nearest town)

WELL PURPOSE: Home
(home, irrigation, municipal, industrial)

- WELL COMPLETION DATA:
- (1) diameter (inches) 2"
 - (2) total depth (feet) 274'
 - (3) static water level (feet) 84' below top of ground
 - (4) casing PVC, 264' (material) (depth)
2" (size) if telescope see back.
 - (5) screen 10' (length), 264' (depth to top)
2" (size), PVC (material)
 - (6) pump 2 hp (HP), 8 1/2 (yield gpm)
Elec. (type power)
 - (7) electric log No. (yes or no)
(organization running log)
 - (8) how well bottom plugged
Rock Wash Valve

description of formations encountered	from	to
Top soil	0	7'
Purple Clay	7'	22'
White Clay	22'	50'
Blue Clay	50'	74'
Red fine sand	74'	106'
Blue Clay	106'	240'
Gray coarse sand	240'	274'

DEPT. OF NATURAL RESOURCES
BUREAU OF LAND & WATER RESOURCES


OCT 19 1981

RECEIVED

DRILLERS REMARKS:

If well telescopes please sketch and show depths.

GROUND LEVEL

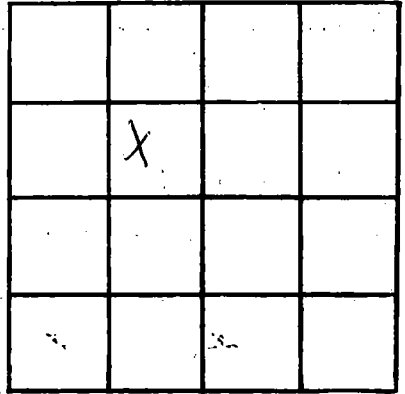

SECTION 29

Please indicate well location X.

ADDITIONAL INFORMATION

If more than one screen, show locations of each on sketch.