

MISSISSIPPI DEPARTMENT OF NATURAL RESOURCES

Bureau of Land and Water Resources

Southport Mall

P.O. Box 10631

Jackson, Mississippi 39209

WATER WELL DRILLERS LOG

Jackson  
R 7042

2-9 1982 Frydog Marine Jackson  
date well completed firm name county well located

LANDOWNER: David Hackler

Rt 1 Box 1134  
Ocean Springs, Ms  
(mailing address) 39564

WELL LOCATION:

sec. 5 T. 5 N R. 4 E  
6 1/2 miles north of Vondra  
(distance) (direction) (nearest town)

WELL PURPOSE:

(home, irrigation, municipal, industrial)

WELL COMPLETION DATA:

- (1) diameter (inches) 2
- (2) total depth (feet) 288
- (3) static water level (feet) 88 (below/above top of ground)
- (4) casing PVC, 278,  
(material) (depth)  
(size) if telescope see back.
- (5) screen 10, 278  
(length) (depth to top)  
2, PVC  
(size) (material)
- (6) pump 1, 6  
(HP) (yield gpm)  
Elect. Pwr.  
(type power)
- (7) electric log (yes or no)

(organization running log)

(8) how well bottom plugged PVC  
Ball Seal

| Description of formations encountered | from | to  |
|---------------------------------------|------|-----|
| Top Soil                              | 0    | 10  |
| Blue Clay                             | 10   | 20  |
| Blue Sand                             | 20   | 22  |
| Blue Clay                             | 22   | 24  |
| Coarse Brown Sand                     | 24   | 30  |
| Sand & Blue Clay                      | 30   | 40  |
| Yellow Clay & Sand                    | 40   | 50  |
| Sandy Clay                            | 50   | 60  |
| Light Sand                            | 60   | 65  |
| Light Sand Clay                       | 65   | 90  |
| Broken Clay                           | 90   | 100 |
| Blue Clay                             | 100  | 208 |
| Dark Brown T Sand                     | 208  | 212 |
| Blue Clay                             | 212  | 240 |
| Dark Blue Sand                        | 240  | 260 |
| Dark Blue Sand                        | 260  | 288 |

DRILLERS REMARKS: Well Produces fairly good at 150' air line. Why should have been sub.


DEPT. OF NATURAL RESOURCES  
BUREAU OF LAND & WATER RESOURCES

APR 6 1982

RECEIVED

If well telescopes please sketch and show depths.

GROUND LEVEL

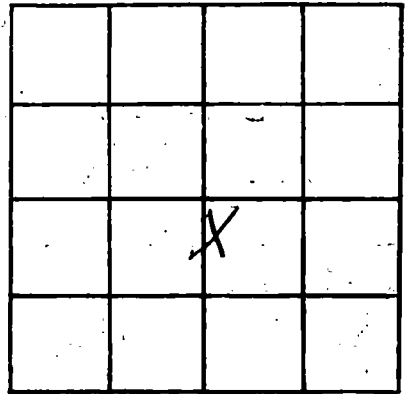

SECTION 27

Please indicate well location X.

**ADDITIONAL INFORMATION**

If more than one screen, show locations of each on sketch.