

W Jackson  
 Comp. 1-8  
 F 2044

MISSISSIPPI DEPARTMENT OF NATURAL RESOURCES

Bureau of Land and Water Resources

Southport Mall

P.O. Box 10631

Mississippi  
 State Office Building

8

Jackson, Mississippi 39209

WATER WELL DRILLERS LOG

2-24-1982 date well completed  
 82 Coast Water Well Sew. Jackson firm name  
 Jackson county well located

LANDOWNER: John Dohy  
 4001 Kinnwood Drive  
 Moss Point, Miss.  
 (mailing address) J5163  
 sec. 21 T 5 N R 7 E  
 4 miles N of VAN CLEAVE  
 (distance) (direction) (nearest town)

description of formations encountered	from	to
R. Clay	0	18'
M.F. Sand	18'	65'
B. Clay	65'	108'
M. Sand	108'	120'

WELL LOCATION:  
 sec. 21 T 5 N R 7 E  
 4 miles N of VAN CLEAVE  
 (distance) (direction) (nearest town)

WELL PURPOSE: Home  
 (home, irrigation, municipal, industrial)

- WELL COMPLETION DATA:
- (1) diameter (inches) 2"
  - (2) total depth (feet) 120'
  - (3) static water level (feet) 30' (below top of ground)
  - (4) casing PVC 110' (material) (depth)  
 2" (size) if telescope see back.
  - (5) screen 10' 110' (length) (depth to top)  
 2" (size) PVC (material)
  - (6) pump 1/2 HP 5 (HP) (yield gpm)  
 Elec. (type power)
  - (7) electric log Yes (yes or no)
- (organization running log)
- (8) how well bottom plugged Back Wash Valve

DEPT. OF NATURAL RESOURCES  
 BUREAU OF LAND & WATER RESOURCES


APR 12 1982

RECEIVED

DRILLERS REMARKS:

If well telescopes please sketch and show depths.

GROUND LEVEL

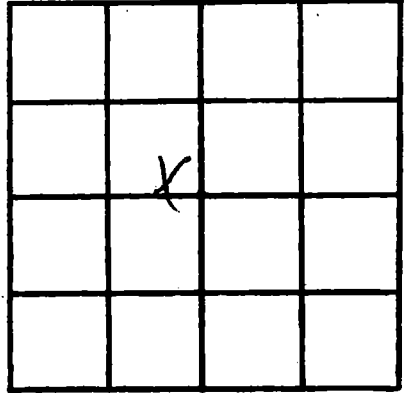

SECTION 21

Please indicate well location X.

ADDITIONAL INFORMATION

If more than one screen, show locations of each on sketch.