

MISSISSIPPI DEPARTMENT OF NATURAL RESOURCES

Bureau of Land and Water Resources

Southport Mall

P.O. Box 10631

Jackson, Mississippi 39209

WATER WELL DRILLERS LOG

Jackson
F 2045

5-18-82
date well completed

Coast Water Well Sew.
firm name

Jackson
county well located

LANDOWNER: Carl Bary

Rt 2 - Box 228
Ocean Springs, Miss.
(mailing address) 32864

description of formations encountered	from	to
Sandy Top soil	0	5'
Gravel clay	5'	30'
M. C. Sand	30'	110'

WELL LOCATION:

sec 33 T 5 S R 7 E
2 miles N of VAN CLEAVE
(distance) (direction) (nearest town)

WELL PURPOSE: Home
(home, irrigation, municipal, industrial)

WELL COMPLETION DATA:

- (1) diameter (inches) 2"
- (2) total depth (feet) 110'
- (3) static water level (feet) 30' ^{below} ~~above~~ top of ground.
- (4) casing PVC 100' (material) (depth)
3" (size) If telescope see back.
- (5) screen 10' 100' (length) (depth to top)
3" (size) PVC (material)
- (6) pump 1 HP 9 (HP) (yield gpm)
Electric (type power)
- (7) electric log No. (yes or no)

(organization running log)

(8) How well bottom plugged
Back wash valve

DRILLERS REMARKS:


DEPT. OF NATURAL RESOURCES
BUREAU OF LAND & WATER RESOURCES

JUN - 4 1982

RECEIVED

If well telescopes please sketch and show depths.

GROUND LEVEL

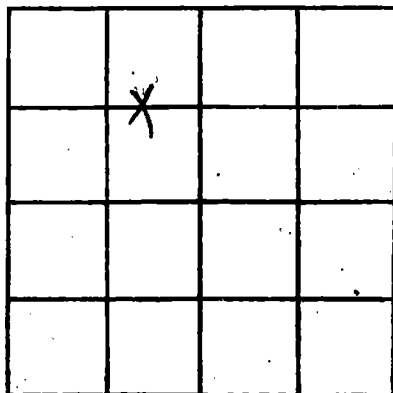

SECTION 33

Please indicate well location X.

ADDITIONAL INFORMATION

If more than one screen,
show locations of each on sketch.