

MISSISSIPPI DEPARTMENT OF NATURAL RESOURCES

Bureau of Land and Water Resources

Southport Mall

P.O. Box 10631

Jackson, Mississippi 39209

WATER WELL DRILLERS LOG

Jackson
F2046

5-18-82 date well completed 82 Coast Water Well Serv. firm name Jackson county well located

LANDOWNER: Worthen, Ben
Rt 2 - Box 285 A.
Ocean Springs, Miss.
(mailing address) 39564

WELL LOCATION:
sec. 33 T 5 R 7E
2 miles (distance) N (direction) of VANGLAND (nearest town)

description of formations encountered	from	to
<u>Top soil</u>	<u>0</u>	<u>14'</u>
<u>C. Sand</u>	<u>14'</u>	<u>30'</u>
<u>R. Clay</u>	<u>30'</u>	<u>55'</u>
<u>M. Sand</u>	<u>55'</u>	<u>93'</u>
<u>R. Clay</u>	<u>93'</u>	<u>100'</u>
<u>C. Sand</u>	<u>100'</u>	<u>126'</u>

WELL PURPOSE: Home
(home, irrigation, municipal, industrial)

WELL COMPLETION DATA:

(1) diameter (inches) 3"

(2) total depth (feet) 126'

(3) static water level (feet) 40' ^{below} _{above} top of ground.

(4) casing PVC. (material), 116' (depth)
2" (size) if telescope see back.

(5) screen 10' (length), 116' (depth to top)
2" (size), PVC (material)

(6) pump 1 1/2 HP. (HP), 7 1/2 (yield gpm)
Elect. (type power)

(7) electric log Yes. (yes or no)

(organization running log)

(8) How well bottom plugged? Back what value

DRILLERS REMARKS:


DEPT. OF NATURAL RESOURCES
BUREAU OF LAND & WATER RESOURCES

JUN - 4 1982

RECEIVED

If well telescopes please sketch and show depths.

GROUND LEVEL

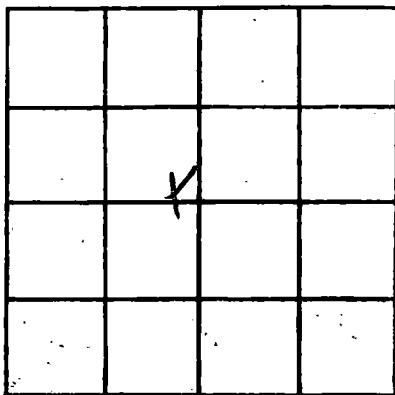

SECTION _____

Please indicate well location X.

ADDITIONAL INFORMATION

If more than one screen,
show locations of each on sketch.