

MISSISSIPPI DEPARTMENT OF NATURAL RESOURCES

Bureau of Land and Water Resources

Southport Mall

P.O. Box 10631

Jackson, Mississippi 39209

WATER WELL DRILLERS LOG

Jackson
FD 248

9-16-82
date well completed

Coast Water Well Sew. Jackson
firm name

county well located

LANDOWNER: Harriet Swin
Rt 2, Box 232 A.
Ocean Springs, Miss.
(mailing address) 39564

description of formations encountered	from	to
<u>Top soil</u>	<u>0</u>	<u>3'</u>
<u>Red Clay</u>	<u>3'</u>	<u>60'</u>
<u>Red Coarse sand</u>	<u>60'</u>	<u>63'</u>
<u>White Clay</u>	<u>63'</u>	<u>110'</u>
<u>Red Coarse sand</u>	<u>110'</u>	<u>117'</u>
<u>Blue Clay</u>	<u>117'</u>	<u>280'</u>
<u>Grey Coarse sand</u>	<u>280'</u>	<u>321'</u>

WELL LOCATION:
sec. 31 T. 5 N. R. 7 W.
2 1/2 miles (distance) NW (direction) of Donn Cleave (nearest town)

WELL PURPOSE: None
(home, irrigation, municipal, industrial)

WELL COMPLETION DATA:

(1) diameter (inches) 2"

(2) total depth (feet) 321'

(3) static water level (feet) 100' (below top of ground)

(4) casing PVC (material), 3 1/2" (depth)
2" (size) if telescope see back.

(5) screen 10' (length), 3 1/2" (depth to top)
2" (size), PVC (material)

(6) pump 1 1/2 (HP), 6- (yield gpm)
Elect. (type power)

(7) electric log No. (yes or no)
(organization running log)

(8) back wash valve
How well bottom plugged

DRILLERS REMARKS:


DEPT. OF NATURAL RESOURCES
BUREAU OF LAND & WATER RESOURCES

SEP-1 1982

RECEIVED

If well telescopes please sketch and show depths.

GROUND LEVEL

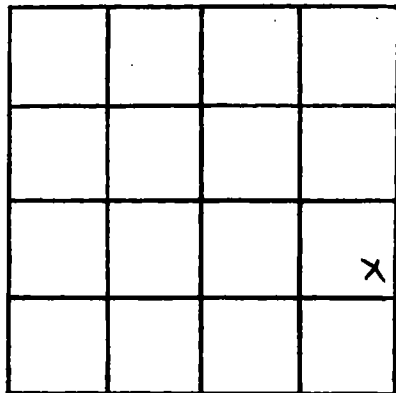

SECTION 31

Please indicate well location X.

ADDITIONAL INFORMATION

If more than one screen, show locations of each on sketch.