

MISSISSIPPI DEPARTMENT OF NATURAL RESOURCES

Bureau of Land and Water Resources

Southport Mall

P.O. Box 10631

Jackson, Mississippi 39209

WATER WELL DRILLERS LOG

Jackson  
FD 249  
7-12

1982 Coast Water Well Sew. Jackson

date well completed firm name county well located

LANDOWNER:

Alex Jantley

description of formations encountered

from

to

16101 Morningside Dr.

Top soil

0 4'

Acacia Springs, Miss.  
 (mailing address) 39564

R. Clay

4' 45'

WELL LOCATION:

M. Sand

45' 100'

sec 28 T 5 N R 7 E  
3 miles N of VANLEAVE  
 (distance) (direction) (nearest town)

WELL PURPOSE: Home  
 (home, irrigation, municipal, industrial)

WELL COMPLETION DATA:

- (1) diameter (inches) 2"
- (2) total depth (feet) 700'
- (3) static water level (feet) 52' below top of ground.
- (4) casing PVC 90'  
 (material) (depth)
- 2" if telescope see back.  
 (size)
- (5) screen 10' 90'  
 (length) (depth to top)
- 2" PVC  
 (size) (material)
- (6) pump 1 hp. 7-  
 (HP) (yield gpm)
- Elect.  
 (type power)
- (7) electric log No.  
 (yes or no)

(organization running log)

(8) how well bottom plugged back with valve

DEPT. OF NATURAL RESOURCES  
 BUREAU OF LAND & WATER RESOURCES


SEP - 1 1982

DRILLERS REMARKS:

RECEIVED

If well telescopes please sketch and show depths.

GROUND LEVEL

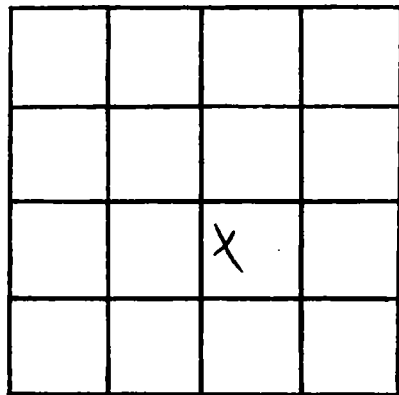

SECTION 28

Please indicate well location X.

ADDITIONAL INFORMATION

If more than one screen, show locations of each on sketch.