

MISSISSIPPI DEPARTMENT OF NATURAL RESOURCES

Bureau of Land and Water Resources

Southport Mall

P.O. Box 10631

Jackson, Mississippi 39209

WATER WELL DRILLERS LOG

Jackson
F 2051

11-8-82 date well completed 19 Coast Water Well Saw. firm name Jackson county well located

LANDOWNER: Leon Hartley
Box 446
Grand Bay, Ala.
(mailing address) 36541

description of formations encountered	from	to
G. Clay	0	25'
C. sand B.	25'	38'
B. Clay	38'	98'
C. sand B	98'	135'
B. Clay	135'	162'
m. sand	162'	184'

WELL LOCATION:
sec. 24 T. 5 S. R. 7 E
5 miles NE of Vandevan
(distance) (direction) (nearest town)

WELL PURPOSE: None
(home, irrigation, municipal, industrial)

WELL COMPLETION DATA:

(1) diameter (inches) 2"

(2) total depth (feet) 184'

(3) static water level (feet) 24' below top of ground.

(4) casing PVC 174' (material) (depth)

3" (size) if telescope see back.

(5) screen 10' 174' (length) (depth to top)

2" PVC (size) (material)

(6) pump 1/2 hp. 9 (HP) (yield gpm)

Elect (type power)

(7) electric log No. (yes or no)

(organization running log)

DEPT. OF NATURAL RESOURCES
BUREAU OF LAND & WATER RESOURCES

DEC 31 1982


RECEIVED

(8) how well bottom plugged
Back work water

DRILLERS REMARKS:

If well telescopes please sketch and show depths.

GROUND LEVEL

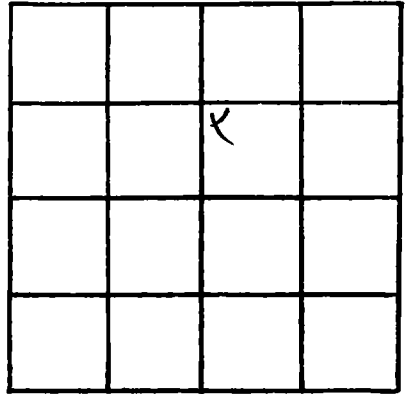

SECTION 24

Please indicate well location X.

ADDITIONAL INFORMATION

If more than one screen,
show locations of each on sketch.