

MISSISSIPPI DEPARTMENT OF NATURAL RESOURCES

Bureau of Land and Water Resources

Southport Mall

P.O. Box 10631

Jackson, Mississippi 39209

WATER WELL DRILLERS LOG

Jackson  
F 2059

11-24-82 19 Coast Water Well Dr. Jackson  
date well completed firm name county well located

LANDOWNER: R. C. Kemmerly  
Box 2 - Box 222  
Ocean Springs, Miss  
(mailing address) 39154

WELL LOCATION:  
sec. 17 T. 5 N. R. 7 E  
5 miles N of VAN CLEAVE  
(distance) (direction) (nearest town)

WELL PURPOSE: Home  
(home, irrigation, municipal, industrial)

- WELL COMPLETION DATA:
- (1) diameter (inches) 2"
  - (2) total depth (feet) 258'
  - (3) static water level (feet) 130' (below top of ground)
  - (4) casing PVC, 220'  
(material) (depth)  
2" if telescope see back.  
(size)
  - (5) screen 10', 220'  
(length) (depth to top)  
2", PVC  
(size) (material)
  - (6) pump 3 h.p., 4  
(HP) (yield gpm)  
Elect.  
(type power)
  - (7) electric log No.  
(yes or no)  
(organization running log)
  - (8) how well bottom plugged Back wash valve

description of formations encountered	from	to
Top soil	0	5'
Red Clay	5'	18'
Red coarse sand	18'	50'
White Clay	50'	76'
Blue Clay	76'	200'
Gray med. sand	200'	205'
Blue Clay	205'	242'
Gray coarse sand	242'	258'

DEPT. OF NATURAL RESOURCES  
BUREAU OF LAND & WATER RESOURCES


DEC 31 1982

RECEIVED

DRILLERS REMARKS:

If well telescopes please sketch and show depths.

GROUND LEVEL

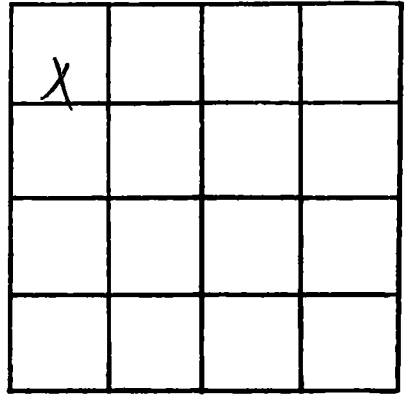

SECTION \_\_\_\_\_

Please indicate well location X.

ADDITIONAL INFORMATION

If more than one screen,  
show locations of each on sketch.