

MISSISSIPPI DEPARTMENT OF NATURAL RESOURCES

Bureau of Land and Water Resources

Southport Mall

P.O. Box 10631

Jackson, Mississippi 39209

WATER WELL DRILLERS LOG

Jackson  
F 2053

12-3-82

date well completed

Coast Water Well Sew.

firm name

Jackson

county well located

LANDOWNER

William R. Fortenberry

description of formations encountered

from

to

Rt 2-Box 292 N

Sandy Top Soil

0 12'

Ocean Springs Miss.  
(mailing address) 39064

Red Clay

12' 43'

WELL LOCATION:

sec 34 T-5 S R-7 W

Blue Clay

43' 100'

2 miles N of VANCELAKE  
(distance) (direction) (nearest town)

Co sand

100' 107'

WELL PURPOSE: Home  
(home, irrigation, municipal, industrial)

Blue Clay

107' 210'

Coarse sand

210' 240'

WELL COMPLETION DATA:

(1) diameter (inches) 4"

(2) total depth (feet) 240'

(3) static water level (feet) 65' below above top of ground.

(4) casing PVC 230'  
(material) (depth)

4" If telescope see back.  
(size)

(5) screen 10' 230'  
(length) (depth to top)

4" PVC  
(size) (material)

(6) pump 1/2 HP 28  
(HP) (yield gpm)

Elect. (type power)

(7) electric log No.  
(yes or no)

(organization running log)

(8) how well bottom plugged  
Back work valve

DRILLERS REMARKS:


DEPT. OF NATURAL RESOURCES  
BUREAU OF LAND & WATER RESOURCES

JAN 11 1983

RECEIVED

If well telescopes please sketch and show depths.

GROUND LEVEL

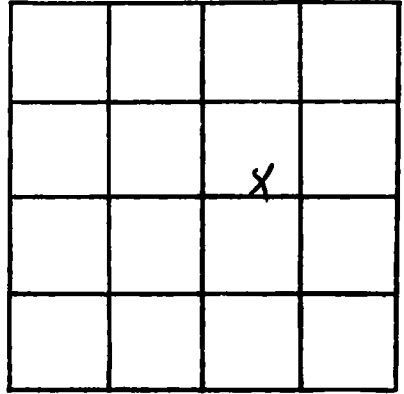

SECTION 34

Please indicate well location X.

ADDITIONAL INFORMATION

If more than one screen,  
show locations of each on sketch.