

MISSISSIPPI DEPARTMENT OF NATURAL RESOURCES

Bureau of Land and Water Resources

Southport Mall

P.O. Box 10631

Jackson, Mississippi 39209

WATER WELL DRILLERS LOG

Jackson
F 2034

4

12-10- 19 *82* *Coast Water Well Sew.* *Jackson*
 date well completed firm name county well located

LANDOWNER *William R. Hallyford*
Vandeventer, Missi.
 (mailing address)

description of formations encountered	from	to
<i>Top soil</i>	<i>0</i>	<i>2'</i>
<i>A. Clay</i>	<i>2'</i>	<i>15'</i>
<i>M. Sand</i>	<i>15'</i>	<i>100'</i>
<i>B. Clay</i>	<i>100'</i>	<i>221'</i>
<i>D. Sand</i>	<i>221'</i>	<i>255'</i>

WELL LOCATION:
 sec *21.5* R *7*
3 miles *N* of *Vandeventer*
 (distance) (direction) (nearest town)

WELL PURPOSE: *Home*
 (home, irrigation, municipal, industrial)

- WELL COMPLETION DATA:
- (1) diameter (inches) *3"*
 - (2) total depth (feet) *255'*
 - (3) static water level (feet) *90'* (below top of ground)
 - (4) casing *PVC*, *245'*
(material) (depth)
3" if telescope see back.
(size)
 - (5) screen *10*, *245'*
(length) (depth to top)
3" *PVC*
(size) (material)
 - (6) pump *2 h.p.*, *6 1/2*
(HP) (yield gpm)
elec.
(type power)
 - (7) electric log *No.*
(yes or no)
 (organization running log)
 - (8) how well bottom plugged *Back Wash Valve*

DEPT. OF NATURAL RESOURCES
 BUREAU OF LAND & WATER RESOURCES


FEB 18 1983

RECEIVED

DRILLERS REMARKS:

If well telescopes please sketch and show depths.

GROUND LEVEL

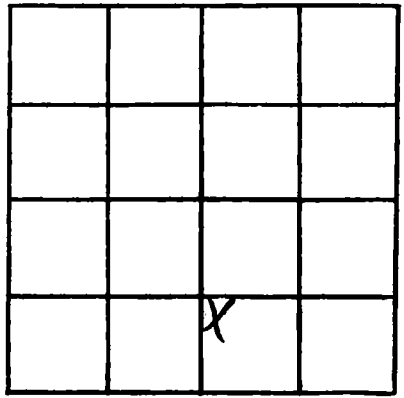

SECTION 21

Please indicate well location X.

ADDITIONAL INFORMATION

A series of horizontal lines for writing additional information.

If more than one screen, show locations of each on sketch.