

MISSISSIPPI DEPARTMENT OF NATURAL RESOURCES

Bureau of Land and Water Resources

Southport Mall

P.O. Box 10631

Jackson, Mississippi 39209

WATER WELL DRILLERS LOG

Jackson
 F 2056

17

2-11 1983 *Coast Water Well Sew.* *Jackson*
 date well completed firm name county well located

LANDOWNER: *E. E. Jones Sr.*
Rd 2 - Box 178 A.
Ocean Springs, Miss.
 (mailing address) *39564*

description of formations encountered	from	to
<i>Top soil</i>	<i>0</i>	<i>5'</i>
<i>Red Clay</i>	<i>5'</i>	<i>27'</i>
<i>Red Coarse sand</i>	<i>27'</i>	<i>74'</i>
<i>Blue Clay</i>	<i>74'</i>	<i>240'</i>
<i>Gray Coarse sand</i>	<i>240'</i>	<i>264'</i>

WELL LOCATION:
 sec *23* T *5* S R *7* W
4 miles *NE* of *VANCLAVE*
 (distance) (direction) (nearest town)

WELL PURPOSE: *Home*
 (home, irrigation, municipal, industrial)

WELL COMPLETION DATA:

(1) diameter (inches) *2"*

(2) total depth (feet) *264'*

(3) static water level (feet) *111* *below* *above*
 top of ground.

(4) casing *PVC*, *254'*
 (material) (depth)

2" If telescope see back.
 (size)

(5) screen *10'*, *254'*
 (length) (depth to top)

2", *PVC*
 (size) (material)

(6) pump _____ (HP) _____ (yield gpm)
Electric
 (type power)

(7) electric log *No.*
 (yes or no)

 (organization running log)

(8) how well bottom plugged
Back Wash Valve

DRILLERS REMARKS:


DEPT. OF NATURAL RESOURCES
 BUREAU OF LAND & WATER RESOURCES

APR 27 1983

RECEIVED

If well telescopes please sketch and show depths.

GROUND LEVEL

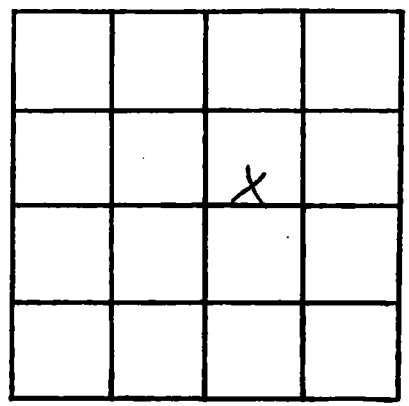

SECTION 23

Please indicate well location X.

ADDITIONAL INFORMATION

If more than one screen, show locations of each on sketch.