

MISSISSIPPI DEPARTMENT OF NATURAL RESOURCES

Bureau of Land and Water Resources

Southport Mall

P.O. Box 10631

Jackson, Mississippi 39209

WATER WELL DRILLERS LOG

Jackson
F2059

3-18-83 date well completed
Coast Water Well Sew. firm name
Jackson county well located

LANDOWNER: Chi Dues
Box 179,
Ocean Springs, Miss.
(mailing address) 33564

WELL LOCATION:
sec. 31 T. 5 N. R. 7 E.
2 miles (distance) NW (direction) of Vandeventer (nearest town)

WELL PURPOSE: Home
(home, irrigation, municipal, industrial)

- WELL COMPLETION DATA:
- (1) diameter (inches) 2"
 - (2) total depth (feet) 300'
 - (3) static water level (feet) 87' below top of ground.
 - (4) casing PVC (material), 290' (depth)
2" (size) if telescope see back.
 - (5) screen 10' (length), 290' (depth to top)
2" (size), PVC (material)
 - (6) pump 3hp. (HP), (yield gpm)
elec. (type power)
 - (7) electric log No. (yes or no)
(organization running log)
 - (8) how well bottom plugged Backwash valve

description of formations encountered	from	to
Top soil	0	2'
Red clay	2'	20'
Red fine sand	20'	50'
Red clay	50'	75'
Red med sand	75'	120'
Blue clay	120'	176'
Blue clay & - st. med sand	176'	195'
Blue clay	195'	267'
Gray coarse sand	267'	300'

DEPT. OF NATURAL RESOURCES
BUREAU OF LAND & WATER RESOURCES


JUN 24 1983

RECEIVED

DRILLERS REMARKS:

If well telescopes please sketch and show depths.

GROUND LEVEL

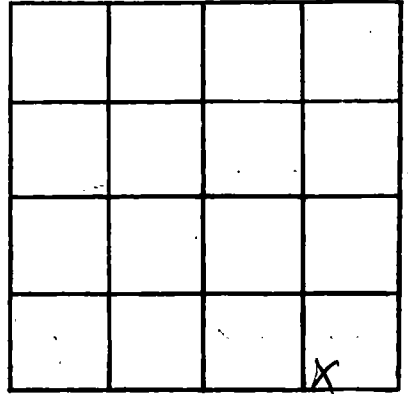

SECTION 31

Please indicate well location X.

ADDITIONAL INFORMATION

If more than one screen,
show locations of each on sketch.