

MISSISSIPPI DEPARTMENT OF NATURAL RESOURCES

Bureau of Land and Water Resources

Southport Mall

P.O. Box 10631

Jackson, Mississippi 39209

WATER WELL DRILLERS LOG

Jackson
F 2059

7-5-83 19 *Coast Water Well Sew.* *Jackson*
date well completed firm name county well located

Carl David Burns
LANDOWNER:

5305 Vanclave Road
Gautier, Miss. 39553
(mailing address)

description of formations encountered	from	to
<i>Top soil</i>	<i>0</i>	<i>2'</i>
<i>red clay</i>	<i>2'</i>	<i>11'</i>
<i>red coarse sand</i>	<i>11'</i>	<i>52'</i>

WELL LOCATION:
sec. *35* T. *5* N. R. *7* E.
3 1/2 miles *NE* of *VANCLAVE*
(distance) (direction) (nearest town)

WELL PURPOSE: *Home*
(home, irrigation, municipal, industrial)

- WELL COMPLETION DATA:
- (1) diameter (Inches) *2"*
 - (2) total depth (feet) *52'*
 - (3) static water level (feet) *35'* *below* *above* top of ground.
 - (4) casing *PVC*, *42'*
(material) (depth)
 - 2"*
(size) if telescope see back.
 - (5) screen *10'*, *42'*
(length) (depth to top)
 - 2"*, *PVC*
(size) (material)
 - (6) pump *—* *—*
(HP) (yield gpm)
 - Electric*
(type power)
 - (7) electric log *No.*
(yes or no)
 - (organization running log)

(8) how well bottom plugged *backwash valve*

DRILLERS REMARKS:


DEPT. OF NATURAL RESOURCES
BUREAU OF LAND & WATER RESOURCES

SEP 21 1983

RECEIVED

If well telescopes please sketch and show depths.

GROUND LEVEL

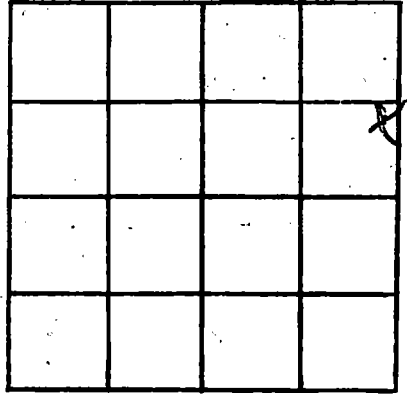

SECTION 35

Please indicate well location X.

ADDITIONAL INFORMATION

If more than one screen,
show locations of each on sketch.