

MISSISSIPPI DEPARTMENT OF NATURAL RESOURCES

Bureau of Land and Water Resources

Southport Mall

P.O. Box 10631

Jackson, Mississippi 39209

WATER WELL DRILLERS LOG

Jackson
F2061

Aug 11th 1983 83 Coast Water Well Serv. Jackson
date well completed firm name county well located

LANDOWNER: William Roy Tortenters
Rt 2-Box 292 N
Ocean Springs, MS
(mailing address) 39564

description of formations encountered	from	to
	Top soil	0
Red Clay	2'	25'
Gray Clay	25'	39'
Blue Clay	39'	106'
Blue fine sand	106'	132'
Blue Clay	132'	155'
Blue fine sand	155'	168'
Blue Clay	168'	220'
Gray coarse sand	220'	237'
Gray coarse sand		
hard wood	237'	245'
Gray coarse sand	245'	258'

WELL LOCATION:
sec. 34 T. 5 S. R. 7 E.
2 miles N of VAN CLEAVE
(distance) (direction) (nearest town)

WELL PURPOSE:
(home, irrigation, municipal, industrial)

- WELL COMPLETION DATA:
- (1) diameter (inches) 4"
 - (2) total depth (feet) 258'
 - (3) static water level (feet) 65' (below top of ground)
 - (4) casing PVC 248' (material) (depth)
4" (size) If telescope see back.
 - (5) screen 10' 248' (length) (depth to top)
4" (size) PVC (material)
 - (6) pump _____ (HP) _____ (yield gpm)
Elec (type power)
 - (7) electric log No (yes or no)
(organization running log)
 - (8) how well bottom plugged
Back Wash Valve


DRILLERS REMARKS:

DEPT. OF NATURAL RESOURCES
BUREAU OF LAND & WATER RESOURCES

SEP 21 1983
RECEIVED

If well telescopes please sketch and show depths.

GROUND LEVEL

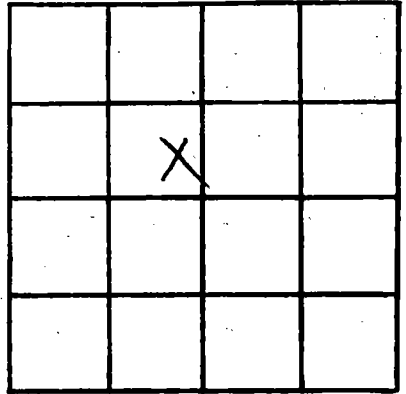

SECTION 34

Please indicate well location X.

ADDITIONAL INFORMATION

If more than one screen, show locations of each on sketch.