

MISSISSIPPI DEPARTMENT OF NATURAL RESOURCES

Bureau of Land and Water Resources

Southport Mall

P.O. Box 10631

Jackson, Mississippi 39209

WATER WELL DRILLERS LOG

Jackson
F 3062

8-31-83

Coast Water Well Sew. Jackson

date well completed

firm name

county well located

LANDOWNER:

Clifford Clifton
1119 Robinson St.

description of formations encountered

from

to

Ocean Springs, Miss
(mailing address) 39564

Top soil

0 3'

Red Clay

3' 26'

Red Coarse sand

26' 93'

WELL LOCATION:

sec 32 T 5 N R 7 E
2 miles N of VAN CLEAVE
(distance) (direction) (nearest town)

WELL PURPOSE:

(home, irrigation, municipal, industrial)

Home

WELL COMPLETION DATA:

(1) diameter (inches) 2"
(2) total depth (feet) 93'
(3) static water level (feet) 10' below top of ground

(4) casing PVC 83'
(material) (depth)
2" (size) if telescope see back.

(5) screen 10' 83'
(length) (depth to top)
2" PVC (size) (material)

(6) pump 1/2 HP 10 (yield gpm)
Electric (type power)

(7) electric log No.
(yes or no)
(organization running log)

(8) How well bottom plugged
Back wash valve

DRILLERS REMARKS:


DEPT. OF NATURAL RESOURCES
BUREAU OF LAND & WATER RESOURCES

SEP 8 1983

RECEIVED

If well telescopes please sketch and show depths.

GROUND LEVEL

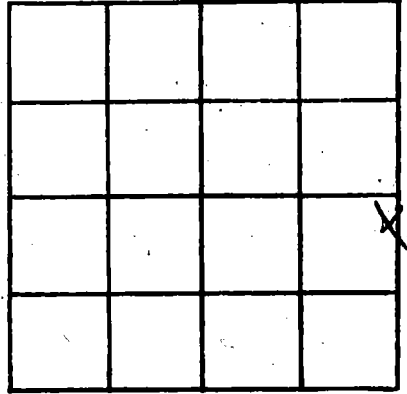

SECTION 32

Please Indicate well location X.

ADDITIONAL INFORMATION

If more than one screen, show locations of each on sketch.