

MISSISSIPPI DEPARTMENT OF NATURAL RESOURCES<sup>12</sup>

Bureau of Land and Water Resources

Southport Mall

P.O. Box 10631

Jackson, Mississippi 39209

WATER WELL DRILLERS LOG

Jackson  
F 2063

8-18 1983 date well completed  
Dingle Well Co. LLC well name  
Jackson county well located

LANDOWNER: BUFOID QUALIS  
402 dupont  
Vance, ms 3945L  
(mailing address)

description of formations encountered

from to

TOP SOIL / SAND	0	20
CLAY	20	80
SAND	80	87
CLAY	87	130
SAND	130	150

WELL LOCATION:

sec. 31 T-5 N R-7 E  
6 miles N of Vance  
(distance) (direction) (nearest town)

WELL PURPOSE:

(home, irrigation, municipal, industrial)

WELL COMPLETION DATA:

- (1) diameter (inches) 2"
- (2) total depth (feet) 150'
- (3) static water level (feet) 80' below top of ground
- (4) casing PVC, 150' (material) (depth)  
2 (size) if telescope see back.
- (5) screen 10' (length), 140' (depth to top)  
#6, PVC (size) (material)
- (6) pump 1 (HP), 7 (yield gpm)  
(type power)
- (7) electric log NO (yes or no)  
(organization running log)

DEPT. OF NATURAL RESOURCES  
BUREAU OF LAND & WATER RESOURCES


NOV - 7 1983

RECEIVED

DRILLERS REMARKS:

If well telescopes please sketch and show depths.

GROUND LEVEL

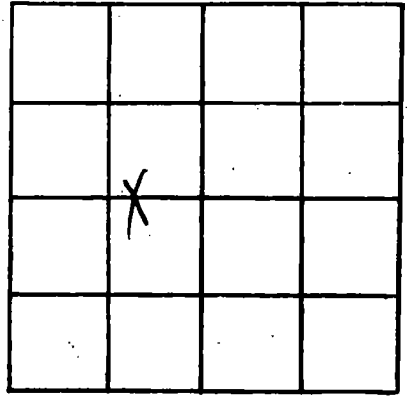

SECTION 5

Please indicate well location X.

ADDITIONAL INFORMATION

If more than one screen, show locations of each on sketch.